


U. S. PUBLIC LAND SURVEY MONUMENT RECORD

SECTION 5 T 18 N, R 5 W, TOWN OF FARMINGTON

LA CROSSE COUNTY

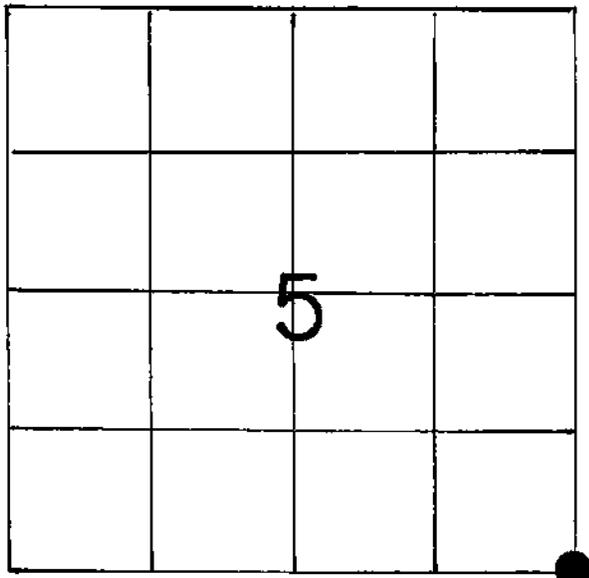

LOCATION OF LANDMARK

Crew: William Jung
 Perry Dahl
 11/15/84

WISCONSIN COORDINATE SYSTEM
North
East
Theta Angle
Horiz. Order
Vert. Order
TYPE OF LANDMARK
2 1/2" Iron Pipe
BEARINGS ARE REFERENCED TO
Assumed

Describe any record evidence, monument evidence, testimonial evidence or any other material evidence you considered and whether the monument was found or restored through acceptance of an obliterated evidence location.

I set a 2 1/2"x8' iron pipe at this corner in September of 1976. Norm Hurlburt used this pipe during a May, 1984 survey. I found my old pipe at the corner.


Describe or show any material discrepancy between the location of the restored corner and that of the corner previously restored or reestablished.

None known.


RECORD OF DURABLE WITNESS MONUMENTS

NO	DESCRIPTION	MAGNETIC	
		BEARING	DISTANCE
1	P.K. Nail in Single-Blazed 12" Oak (in clump)	S86°W	19.87'
2	P.K. Nail in Single-Blazed 9" Jack Pine	S15°W	34.05'
3	P.K. Nail in Single-Blazed 10" Oak	S88°E	34.31'
4	P.K. Nail in Single-Blazed 8" Norway Pine	N18°E	12.78'

(Each distance is to a P.K. nail in a hack on the side of the tree, except for no. 4 where the P.K. nail is in the base in a hack.)

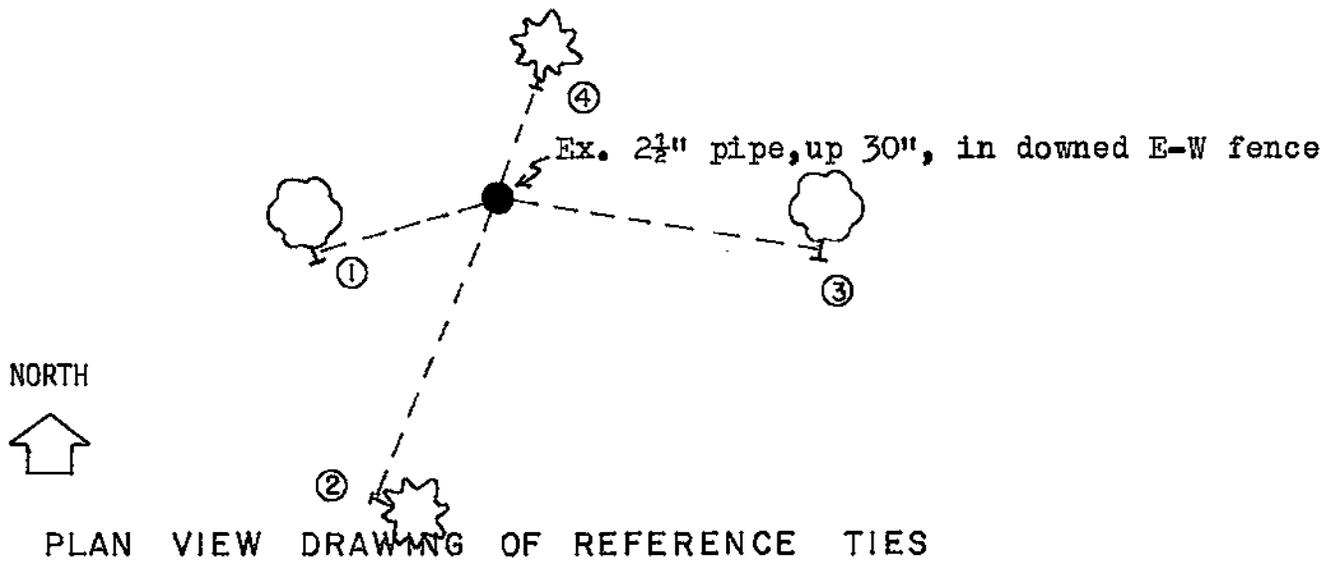


MAP SHOWING DISTANCE AND DIRECTION TO OTHER PUBLIC LAND SURVEY CORNERS USED FOR REESTABLISHING THE CORNER
(not to scale)

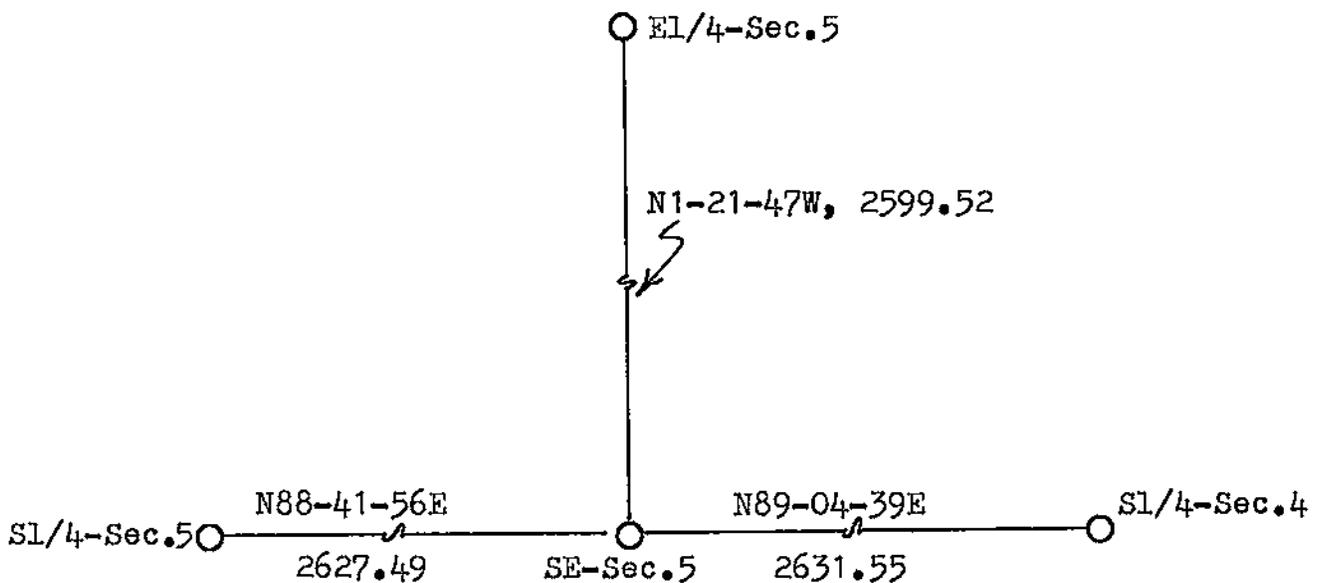

I, William C. Jung, Deputy County Surveyor,
HEREBY CERTIFY THAT THE CORNER LOCATION SHOWN ON THIS RECORD
WAS DETERMINED BY ME OR UNDER MY DIRECTION AND CONTROL AND
THAT THIS U. S. PUBLIC LAND SURVEY MONUMENT RECORD IS CORRECT
AND COMPLETE TO THE BEST OF MY KNOWLEDGE AND BELIEF.

William C. Jung
Signature

3/7/86
Date

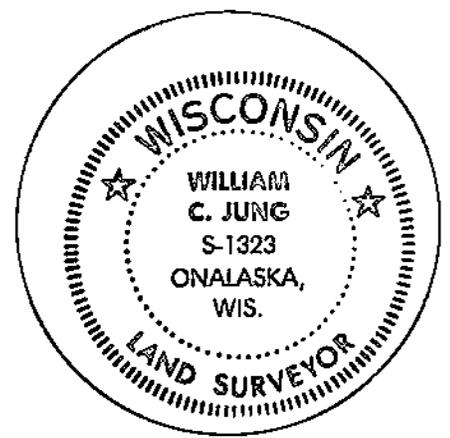

Seal