


21805050020

## U. S. PUBLIC LAND SURVEY MONUMENT RECORD

SECTION 5 T 18 N, R 5 W, TOWN OF FARMINGTON

LA CROSSE COUNTY

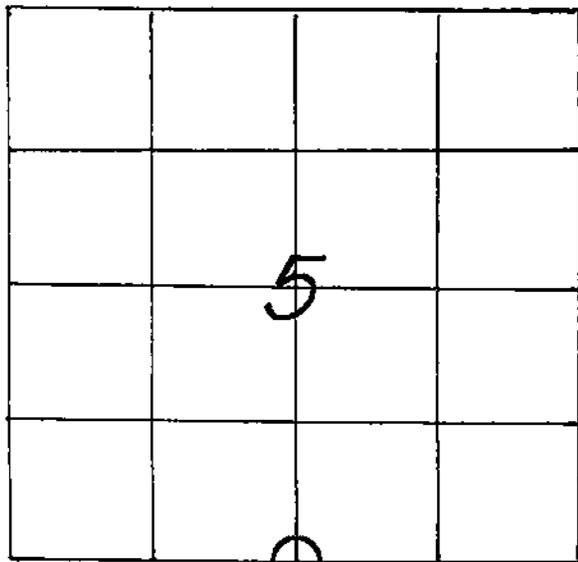

LOCATION OF LANDMARK

CREW: WILLIAM C. JUNG  
 PETER F. FOLLANSBEE  
 DATE: 3/16/2005

## WISCONSIN COORDINATE SYSTEM

North

East

Theta Angle

Horiz. Order

Vert. Order

## TYPE OF LANDMARK

*2-1/2" IRON PIPE.*

BEARINGS ARE REFERENCED TO

Describe any record evidence, monument evidence, testimonial evidence or any other material evidence you considered and whether the monument was found or restored through acceptance of an obliterated evidence location.


I found the pipe that I set back in 1976 and took new ties. (See my old tie sheet for corner history.)

Describe or show any material discrepancy between the location of the restored corner and that of the corner previously restored or reestablished.

**NONE KNOWN.**

RECORD OF DURABLE WITNESS MONUMENTS

NO	DESCRIPTION	MAGNETIC	
		BEARING	DISTANCE
1	SET A NAIL IN N.E.-SIDE OF A 14" JACK PINE	N 77° W	21.31 FT.
2	SET A NAIL IN S.W.-SIDE OF A 7" NORWAY	N 19° W	14.95 FT.
3	SET A NAIL IN S.E.-SIDE OF A 6" NORWAY	N 79° E	8.30 FT.
4	SET A NAIL IN S.W.-SIDE OF A 6" NORWAY	S 25° E	14.13 FT.

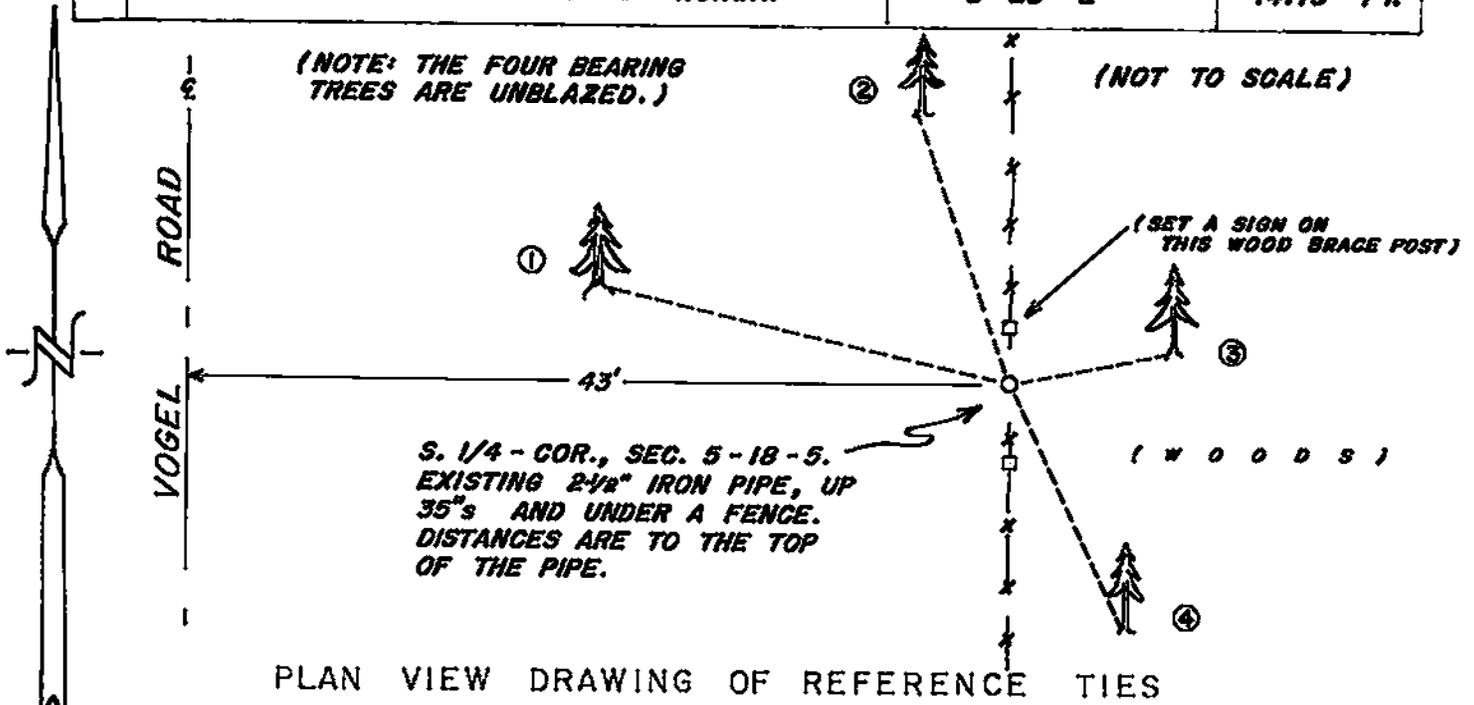

MAP SHOWING DISTANCE AND DIRECTION TO OTHER PUBLIC LAND SURVEY CORNERS USED FOR REESTABLISHING THE CORNER

(see surveys of record for survey data)

I, WILLIAM G. JUNG, COUNTY SURVEYOR  
HEREBY CERTIFY THAT THE CORNER LOCATION SHOWN ON THIS RECORD WAS DETERMINED BY ME OR UNDER MY DIRECTION AND CONTROL AND THAT THIS U. S. PUBLIC LAND SURVEY MONUMENT RECORD IS CORRECT AND COMPLETE TO THE BEST OF MY KNOWLEDGE AND BELIEF.

William G. Jung  
Signature

3/14/06  
Date



Seal

LaCrosse County U.S. Public Land Survey Monument Record

RECORD OF LAND CORNER PERPETUATION

No. \_\_\_\_\_

STATE OF WISCONSIN

County of Monroe } ss.

I, William C. Jung, hereby certify that the information shown hereon correctly describes the original corner, resurvey information, evidence found, type of monument found or placed, and witness monuments and accessories used to perpetuate the location of the original or established corner.

Dated this 25th day of July, 1983.

at Tomah, Wisconsin.


William C. Jung  
Registered Land Surveyor 1323  
Title

COUNTY <b>LaCrosse</b>		
TOWN <b>Farmington</b>		
HIGHWAY <b>East of Vogel Road</b>		
SECTION <b>8</b>	TOWNSHIP <b>T18N</b>	RANGE <b>R5W</b>
TYPE OF LANDMARK <b>2 1/2" x 8' Iron Pipe</b>		

Date of Survey June 10, 1983



Drafted by Jung

Date July 25, 1983

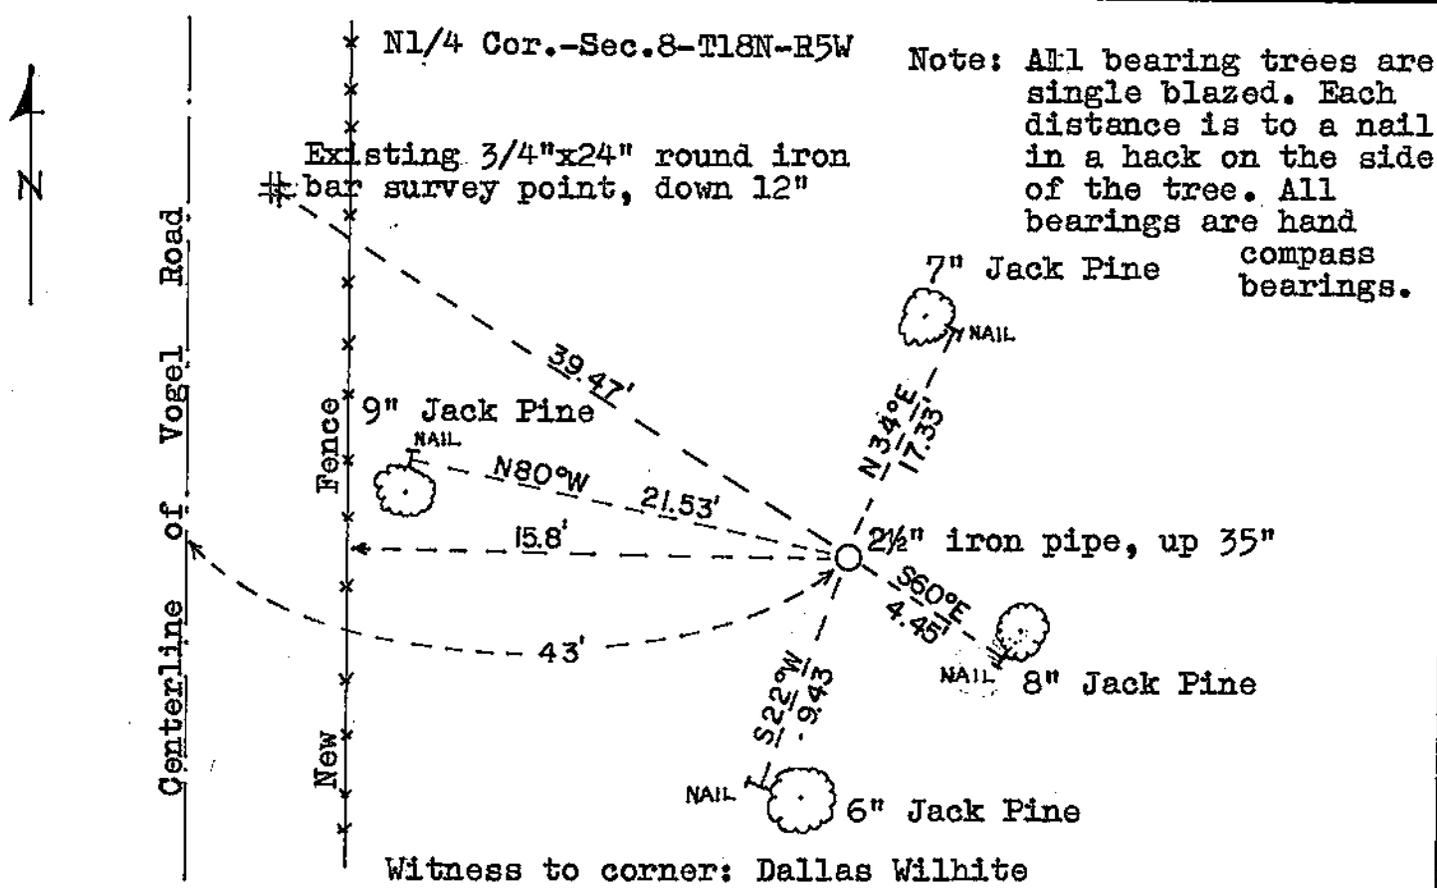

Witness to corner: Dallas Wilhite

WISCONSIN COORDINATE SYSTEM	
North	Zone
East	
Elevation	Theta Angle
Vertical control order	
Horizontal control order	

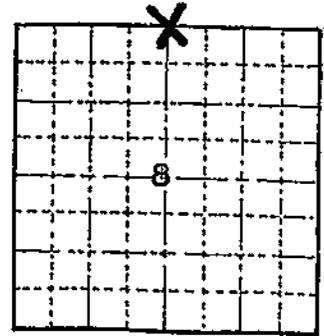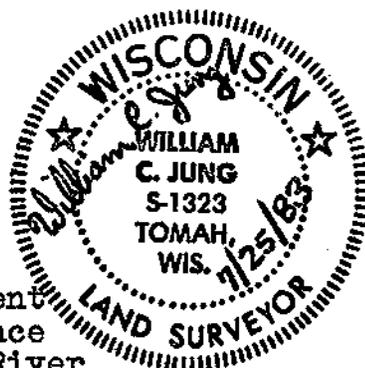

REMARKS: I set the pipe at its present position on September 3, 1976. Since that date Norm Hurlburt of Black River Falls has used this pipe as the corner. In 1976 I found no evidence of the original government corner or its perpetuation. I set the corner by intersecting the occupied North-South 1/4 line with an old and long occupied fence on the North line of the NE1/4-NE1/4 of Section 8. Set as such, I found the location fits the evidence in Section 8 very well.

LOCATION SKETCH  
(Location of landmark indicated by "x")