


21805052020

U. S. PUBLIC LAND SURVEY MONUMENT RECORD

SECTION 5 T 18 N, R 5 W, TOWN OF FARMINGTON
 LA CROSSE COUNTY

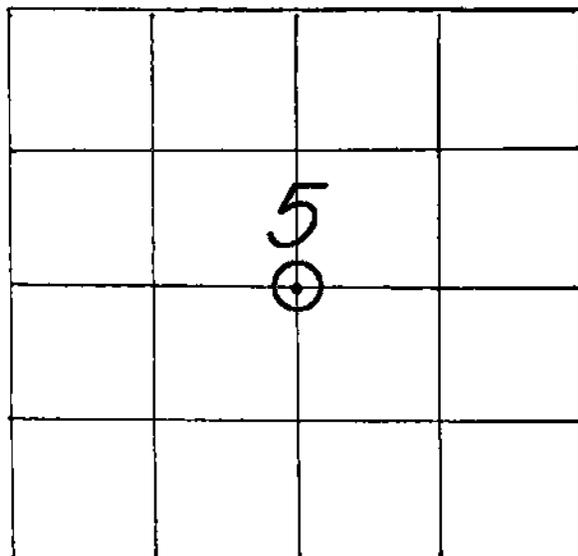

LOCATION OF LANDMARK

CREW: *WILLIAM C. JUNG*
PETER F. FOLLANSBEE
 DATE: *3/15/2008*

WISCONSIN COORDINATE SYSTEM

North

East

Theta Angle

Horiz. Order

Vert. Order

TYPE OF LANDMARK

IRON PIPE WITH A PLASTIC PLUG.

BEARINGS ARE REFERENCED TO

Describe any record evidence, monument evidence, testimonial evidence or any other material evidence you considered and whether the monument was found or restored through acceptance of an obliterated evidence location.

I found a pipe at the corner and took new ties.


Describe or show any material discrepancy between the location of the restored corner and that of the corner previously restored or reestablished.

NONE KNOWN.

RECORD OF DURABLE WITNESS MONUMENTS

NO	DESCRIPTION	MAGNETIC	
		BEARING	DISTANCE
1	SET A NAIL IN N.E.-SIDE OF A 13" OAK	N 14° W	33.38 FT.
2	SET A NAIL IN N.W.-SIDE OF A 12" OAK	N 10 1/2° E	23.43 FT.
3	SET A NAIL IN S.W.-SIDE OF A 6" WHITE PINE	S 30° E	8.56 FT.
4	SET A NAIL IN S.-SIDE OF A 4" WHITE PINE (w/ SIGN)	N 88° W	6.68 FT.

(NOT TO SCALE)

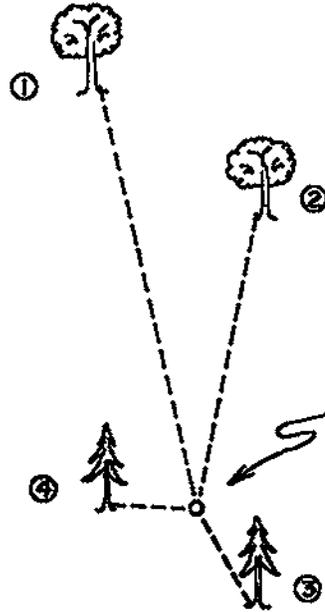

(NOTE: BEARING TREES 1, 2 AND 3 ARE DOUBLE BLAZED WHILE No. 4 WAS LEFT UNBLAZED.)

(W O O D S)

C. 1/4-COR., SEC. 5-18-5.
EXISTING IRON PIPE SET FLUSH WITH A YELLOW, PLASTIC "HURLBURT" PLUG INSIDE THE TOP. THERE IS A STEEL FENCE POST TO THE SOUTH AND A "FOREST" SIGN TO THE SOUTHEAST.

PLAN VIEW DRAWING OF REFERENCE TIES

MAP SHOWING DISTANCE AND DIRECTION TO OTHER PUBLIC LAND SURVEY CORNERS USED FOR REESTABLISHING THE CORNER

(refer to survey data of record for section measurements)

I, WILLIAM C. JUNG, COUNTY SURVEYOR
HEREBY CERTIFY THAT THE CORNER LOCATION SHOWN ON THIS RECORD WAS DETERMINED BY ME OR UNDER MY DIRECTION AND CONTROL AND THAT THIS U. S. PUBLIC LAND SURVEY MONUMENT RECORD IS CORRECT AND COMPLETE TO THE BEST OF MY KNOWLEDGE AND BELIEF.

William C. Jung
Signature

3/14/06
Date




Seal

U. S. PUBLIC LAND SURVEY MONUMENT RECORD

SECTION 5 T 18 N, R 5 W, TOWN OF FARMINGTON

LA CROSSE COUNTY

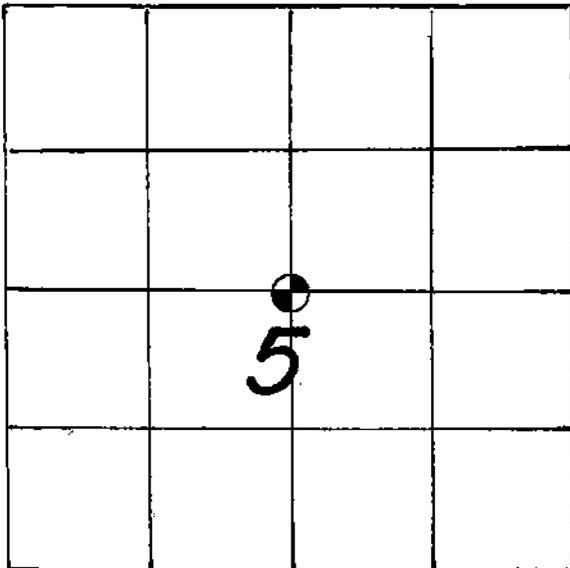

LOCATION OF LANDMARK

DATE: 1-14-85
CREW: BILL JUNG

WISCONSIN COORDINATE SYSTEM

North

East

Theta Angle

Horiz. Order

Vert. Order

TYPE OF LANDMARK

1 1/4" IRON PIPE WITH PLUG

BEARINGS ARE REFERENCED TO

Describe any record evidence, monument evidence, testimonial evidence or any other material evidence you considered and whether the monument was found or restored through acceptance of an obliterated evidence location.

I found an iron pipe set at the True Center 1/4 Corner in May of 1984. The pipe was set by Norm Hurlburt.

Describe or show any material discrepancy between the location of the restored corner and that of the corner previously restored or reestablished.


None known.

RECORD OF DURABLE WITNESS MONUMENTS

MAGNETIC

NO	DESCRIPTION	BEARING	DISTANCE
1	NAIL IN 6" DOUBLE BLAZED OAK TREE	N10°W	28.57'
2	NAIL IN 9" DOUBLE BLAZED JACK PINE	S88°W	11.05'
3	NAIL IN 13" DOUBLE BLAZED OAK TREE	S77°E	5.21'
4	NAIL IN 12" DOUBLE BLAZED JACK PINE	N50°E	13.75'

(Each distance is to a nail in a hack on the side of the tree.)

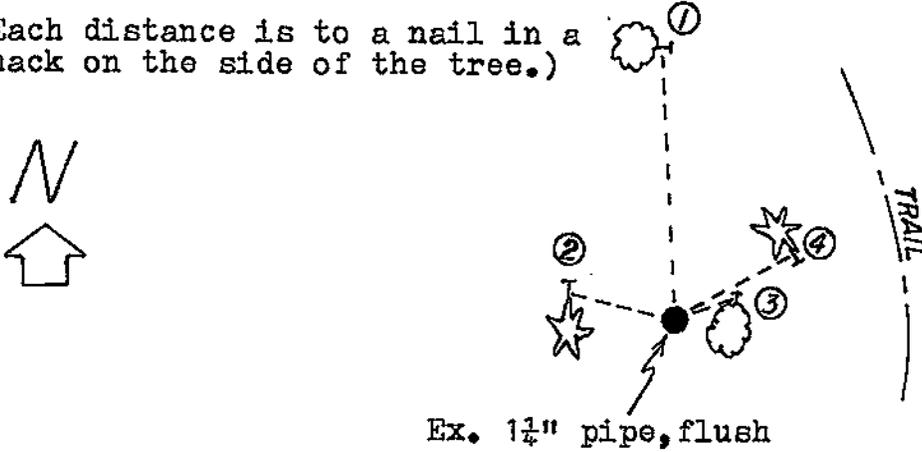

PLAN VIEW DRAWING OF REFERENCE TIES


MAP SHOWING DISTANCE AND DIRECTION TO OTHER PUBLIC LAND SURVEY CORNERS USED FOR REESTABLISHING THE CORNER

No measurements made by me at this time.

I, William C. Jung, Deputy County Surveyor,
 HEREBY CERTIFY THAT THE CORNER LOCATION SHOWN ON THIS RECORD
 WAS DETERMINED BY ME OR UNDER MY DIRECTION AND CONTROL AND
 THAT THIS U. S. PUBLIC LAND SURVEY MONUMENT RECORD IS CORRECT
 AND COMPLETE TO THE BEST OF MY KNOWLEDGE AND BELIEF.

William C. Jung
 Signature

3/7/86
 Date

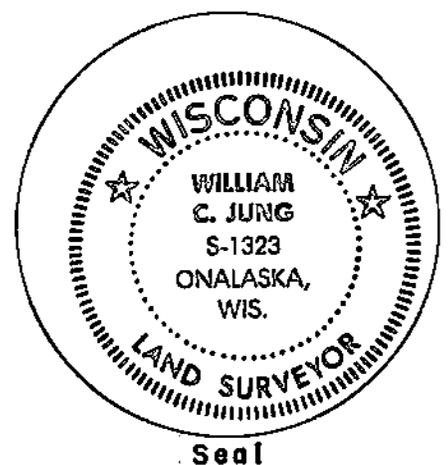

Seal