


21805060020

U. S. PUBLIC LAND SURVEY MONUMENT RECORD

SECTION 6 T 18 N, R 5 W, TOWN OF FARMINGTON

LA CROSSE COUNTY

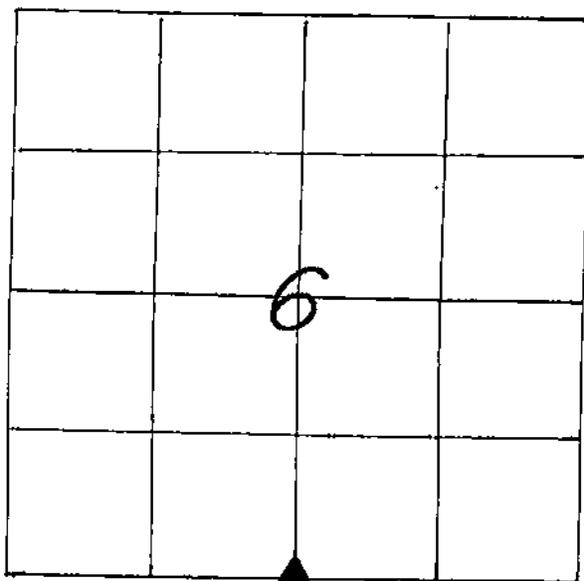

LOCATION OF LANDMARK

CREW: WILLIAM C. JUNG
 PETER F. FOLLANSBEE
 DATE: 7/27/1999

WISCONSIN COORDINATE SYSTEM

North

East

Theta Angle

Horiz. Order

Vert. Order

TYPE OF LANDMARK

EXISTING RAILROAD SPIKE IN PAVEMENT.

BEARINGS ARE REFERENCED TO

Assumed

Describe any record evidence, monument evidence, testimonial evidence or any other material evidence you considered and whether the monument was found or restored through acceptance of an obliterated evidence location.


In 1987 Norm Hurlburt found a P.K. nail at this corner. Dennis Malichar used this corner location in a survey in 1992. In 1987 I could not find the P.K. nail and assumed that it had been knocked out. Rodney Maxwell apparently set a railroad spike at Hurlburt's old location. This fit the old occupied conditions very well. I accepted this location as the best available evidence of the original government corner position.

Describe or show any material discrepancy between the location of the restored corner and that of the corner previously restored or reestablished.

NONE KNOWN.

RECORD OF DURABLE WITNESS MONUMENTS
MAGNETIC


| NO | DESCRIPTION | BEARING | DISTANCE |
|----|---|-----------|------------|
| 1 | EXISTING ROUND 5/8" IRON BAR | N 01° W | 33.00 FT. |
| 2 | EXISTING G.P.S. MARKER STAMPED "BURR OAK" | N 85° E ± | 386.15 FT. |
| 3 | SET A NAIL IN S.W.-SIDE 6-1/2" JACK PINE | S 35° E | 53.68 FT. |
| 4 | SET A NAIL IN N.E.-SIDE 4" WHITE OAK | S 21° E | 46.35 FT. |

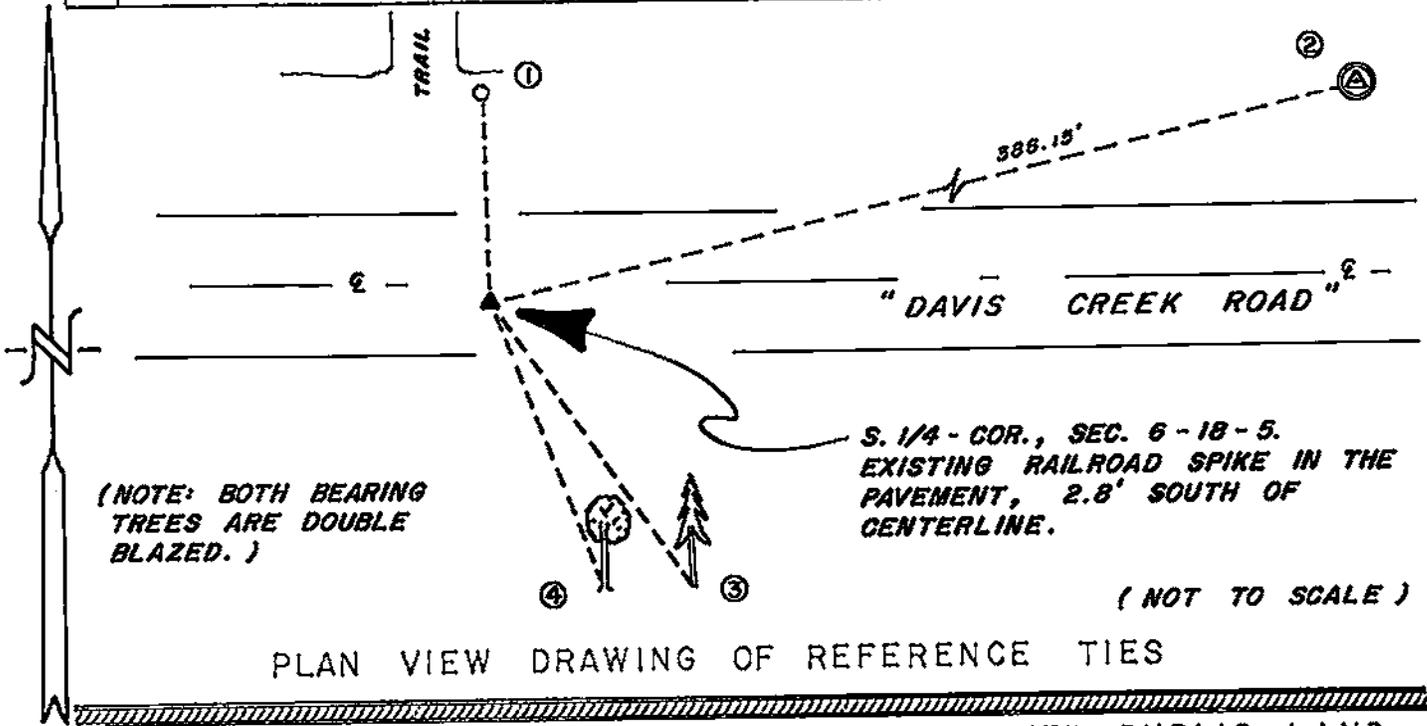

MAP SHOWING DISTANCE AND DIRECTION TO OTHER PUBLIC LAND SURVEY CORNERS USED FOR REESTABLISHING THE CORNER

(not to scale)

(MAXWELL MEASUREMENTS)

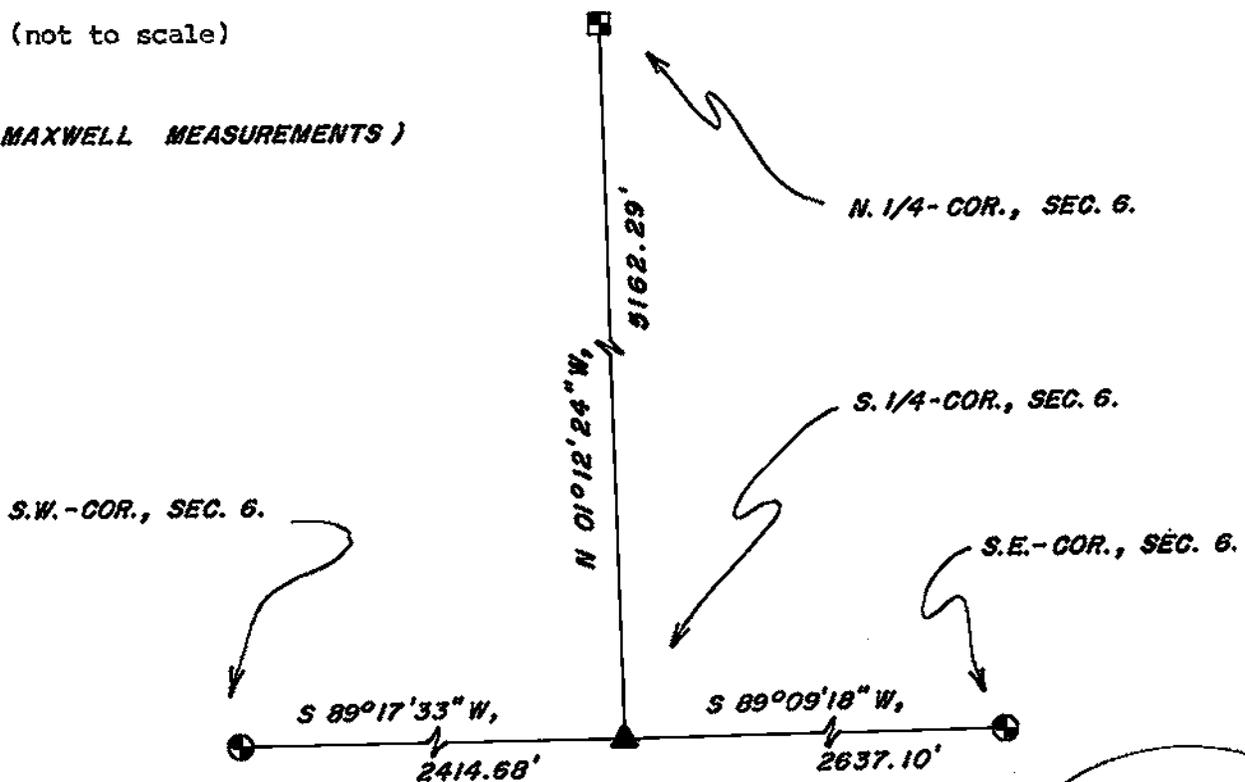

I, WILLIAM C. JUNG, COUNTY SURVEYOR
HEREBY CERTIFY THAT THE CORNER LOCATION SHOWN ON THIS RECORD WAS DETERMINED BY ME OR UNDER MY DIRECTION AND CONTROL AND THAT THIS U. S. PUBLIC LAND SURVEY MONUMENT RECORD IS CORRECT AND COMPLETE TO THE BEST OF MY KNOWLEDGE AND BELIEF.

William C. Jung 8/9/99
Signature Date

