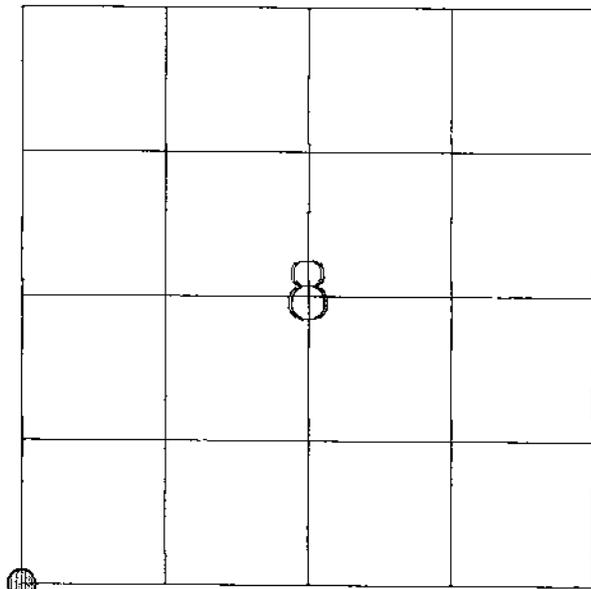


21805070000

U S. PUBLIC LAND SURVEY MOUMENT RECORD

SECTION 8, T.18N., R.5W., TOWN OF FARMINGTON,
LaCROSSE COUNTY, WISCONSIN

LOCATION OF LANDMARK

WISCONSIN COORDINATE SYSTEM	
North	N/A
East	N/A
Theta Angle	N/A
Horiz. Order	N/A
Vert. Order	N/A
TYPE OF LANDMARK:	
Set 3/4" X 24" Iron Pipe	
BEARINGS ARE REFERENCED TO:	
the South line of the S.E.1/4 of Section 7, recorded to bear S89°39'49"E.	

Crew: Rodney H. Maxwell
Dwayne M. Hefner
Laurence E. Johns III

Date: 16 July 1998

Describe any record evidence, monument evidence, testimonial evidence or any other material evidence you considered and whether the monument was found or restored through acceptance of an obliterated evidence location.

A line was extended Easterly from the S.W. Corner of Section 7 through an occupied fence corner at the South 1/4 corner of Section 7. Another line was extended Westerly from the S.E. Corner of Section 8 through the South 1/4 Corner of Section 8. These two lines were intersected by a line extended from the West 1/4 corner of Section 8 Southerly through an occupied fence corner near the N.W. corner of the S.W.1/4 of the S.W.1/4. The distance between the two extended lines at the intersecting line from the North was split in half and the corner was set at that location.


Describe or show any material discrepancy between the location of the restored corner and that of the corner previously restored or reestablished.

No record of corner being restored since original government survey.

RECORD OF DURABLE WITNESS MONUMENTS


NO.	DESCRIPTION	BEARING	DISTANCE
1	6" White Oak	N 64°05' E	6.3'
2	8" Red Oak	S 37°26' E	10.4'
3	10" White Oak	S 29°16' W	16.7'
4	4" Red Oak	S 35°15' E	15.8'

** All trees double blazed with
MAG Nails in lower hack.

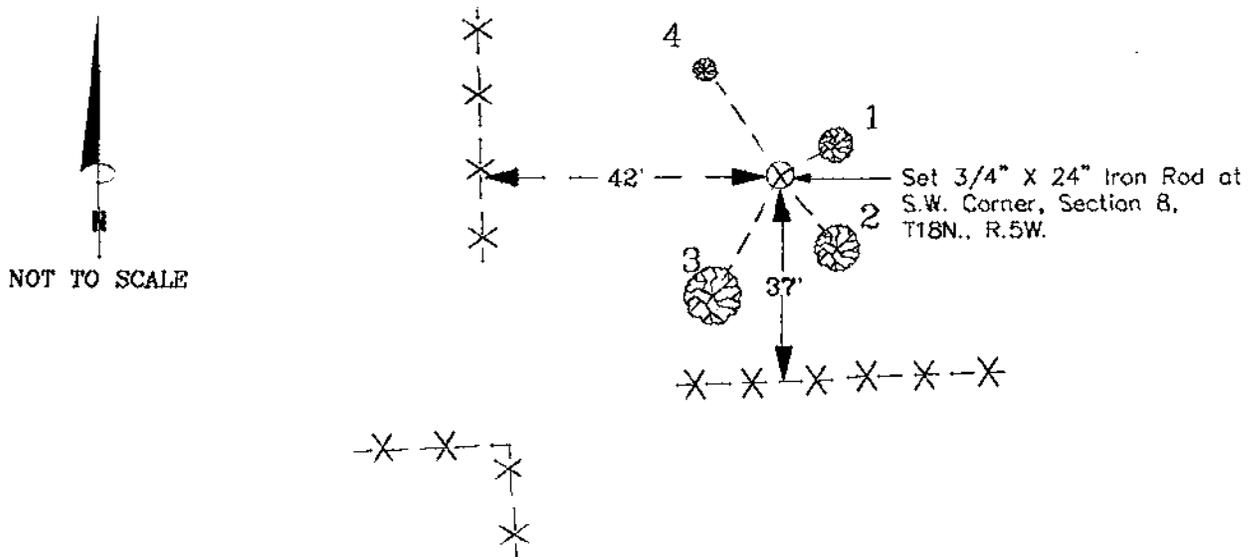

PLAN VIEW DRAWING OF REFERENCE TIES


MAP SHOWING DISTANCE AND DIRECTION TO OTHER PUBLIC LAND SURVEY
CORNERS USED FOR REESTABLISHING THE CORNER

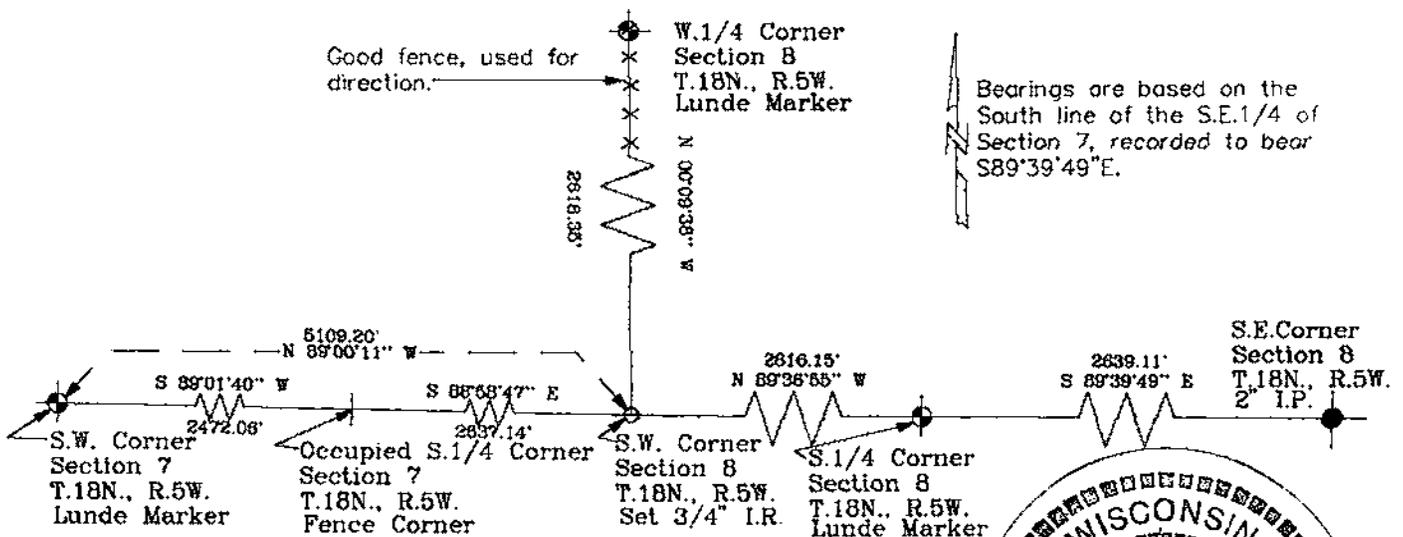

I, RODNEY H. MAXWELL, REGISTERED LAND SURVEYOR, HEREBY CERTIFY THAT THE CORNER LOCATION SHOWN ON THIS RECORD WAS DETERMINED BY ME OR UNDER MY DIRECTION AND CONTROL, AND THAT THIS U. S. PUBLIC LAND SURVEY MONUMENT RECORD IS CORRECT AND COMPLETE TO THE BEST OF MY KNOWLEDGE AND BELIEF

Rodney H. Maxwell

Rodney H. Maxwell
Maxwell Surveying
7457 Highway 16, Suite C
Sparta, Wisconsin
20 July 1998

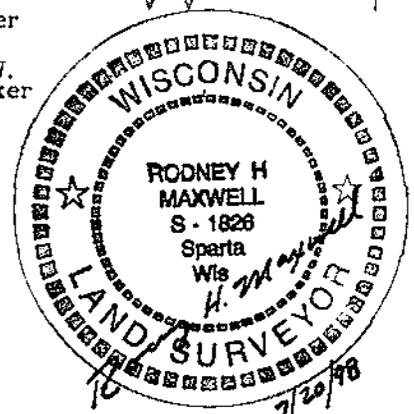

SEAL