


## U. S. PUBLIC LAND SURVEY MONUMENT RECORD

SECTION 8 T 18 N, R 5 W, TOWN OF Farmington

LA CROSSE COUNTY

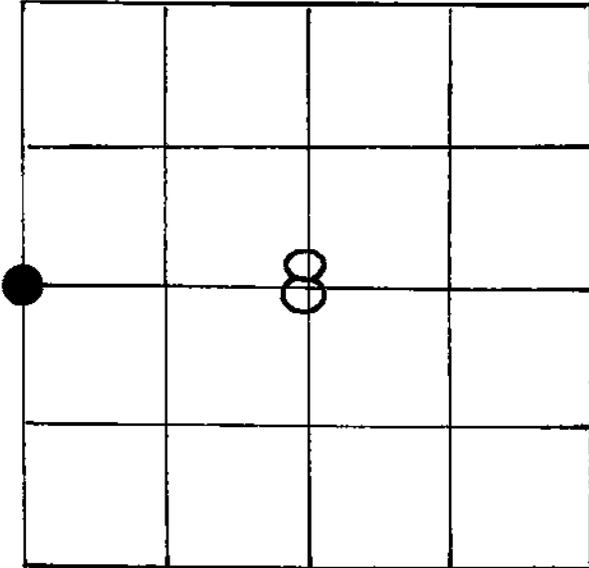

LOCATION OF LANDMARK

Crew: William C. Jung  
Peter F. Follansbee

Date: November 2, 1990

Describe any record evidence, monument evidence, testimonial evidence or any other material evidence you considered and whether the monument was found or restored through acceptance of an obliterated evidence location.

In September of 1976 I set an iron bar at the occupied fence corner after accepting the fence corner as the best available evidence of the original government corner position. I removed the iron bar and replaced it with a Lunde marker. I buried a whiskey bottle with a shell casing on the East side of the Lunde marker with a beer bottle on top of the whiskey bottle.

Describe or show any material discrepancy between the location of the restored corner and that of the corner previously restored or reestablished.

None known.

## WISCONSIN COORDINATE SYSTEM

North

East

Theta Angle

Horiz. Order

Vert. Order

## TYPE OF LANDMARK


Brass capped Lunde marker

BEARINGS ARE REFERENCED TO

RECORD OF DURABLE WITNESS MONUMENTS

Magnetic

NO	DESCRIPTION	BEARING	DISTANCE
1	P.K. nail in double blazed 8" jack pine	S35°W	43.75
2	" 8" Norway	N45°W	36.13
3	" 10" oak	N19°W	18.84
4	" 9" oak	S16°E	6.75

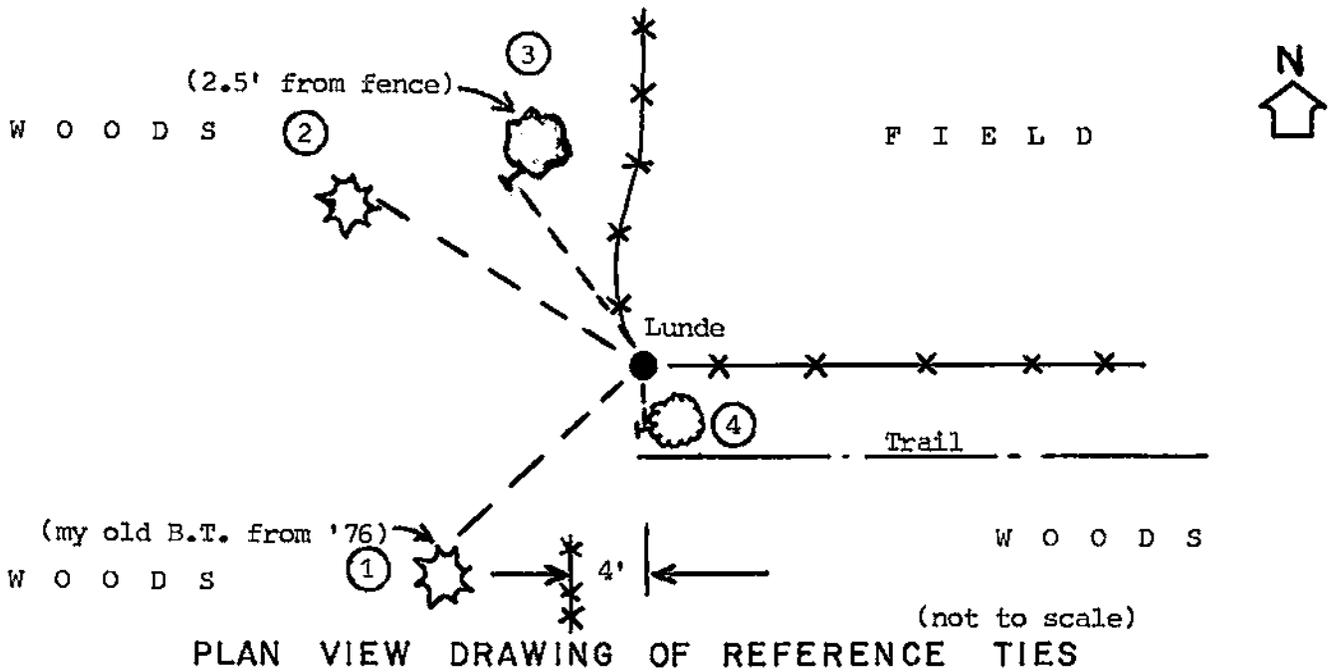


MAP SHOWING DISTANCE AND DIRECTION TO OTHER PUBLIC LAND SURVEY CORNERS USED FOR REESTABLISHING THE CORNER

No new section measurements made by me at this time. Refer to my 1976 section data.

I, William C. Jung, Deputy County Surveyor,  
 HEREBY CERTIFY THAT THE CORNER LOCATION SHOWN ON THIS RECORD  
 WAS DETERMINED BY ME OR UNDER MY DIRECTION AND CONTROL AND  
 THAT THIS U. S. PUBLIC LAND SURVEY MONUMENT RECORD IS CORRECT  
 AND COMPLETE TO THE BEST OF MY KNOWLEDGE AND BELIEF.

William C. Jung  
 Signature

February 7, 1991  
 Date

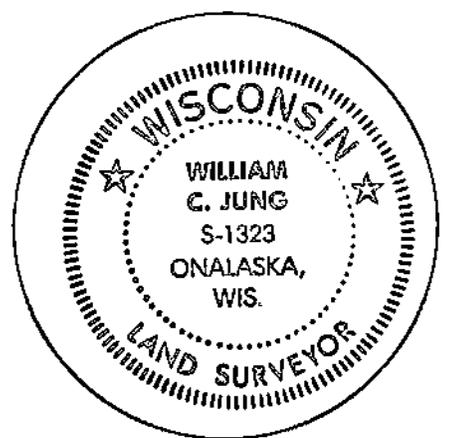

Seal