


21805080000

U. S. PUBLIC LAND SURVEY MONUMENT RECORD

SECTION 9 T 18 N, R 5 W, TOWN OF FARMINGTON
 LA CROSSE COUNTY

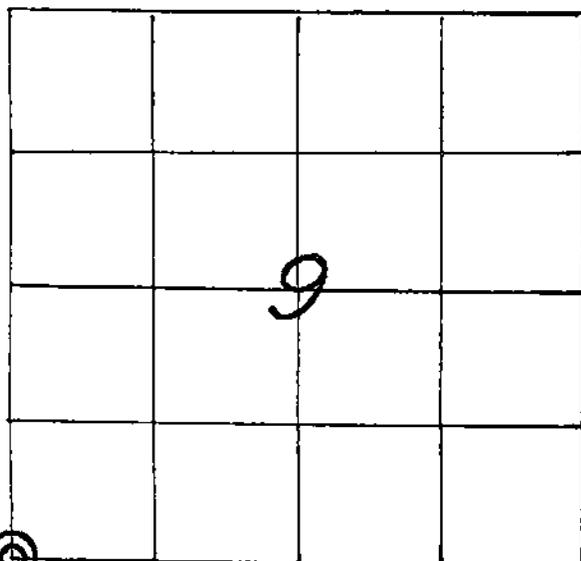

LOCATION OF LANDMARK

CREW: WILLIAM C. JUNG
 PETER F. FOLLANSBEE
 DATE: 3/08/2007

WISCONSIN COORDINATE SYSTEM
North
East
Theta Angle
Horiz. Order
Vert. Order
TYPE OF LANDMARK
EX. 1/4" IRON PIPE INSIDE A 2-1/4" IRON PIPE.
BEARINGS ARE REFERENCED TO

Describe any record evidence, monument evidence, testimonial evidence or any other material evidence you considered and whether the monument was found or restored through acceptance of an obliterated evidence location.


We found our pipe of record and set a red plastic cap in the 1 1/4" pipe and made new ties. The three old oak bearing trees were dead. A sign and post were set to the east.

Describe or show any material discrepancy between the location of the restored corner and that of the corner previously restored or reestablished.

NONE KNOWN.

RECORD OF DURABLE WITNESS MONUMENTS

NO	DESCRIPTION	MAGNETIC	
		BEARING	DISTANCE
1	SET A NAIL IN N.W.-SIDE OF A 16" HICKORY	S 20° W	16.97 FT.
2	SET A NAIL IN S.E.-SIDE OF A 4-1/2" CEDAR	S 66° W	17.10 FT.
3	SET A NAIL IN N.E.-SIDE OF AN 8" HICKORY	N 40° W	21.14 FT.
4	SET A NAIL IN S.E.-SIDE OF A 4-1/4" HICKORY	N 20° E	16.56 FT.

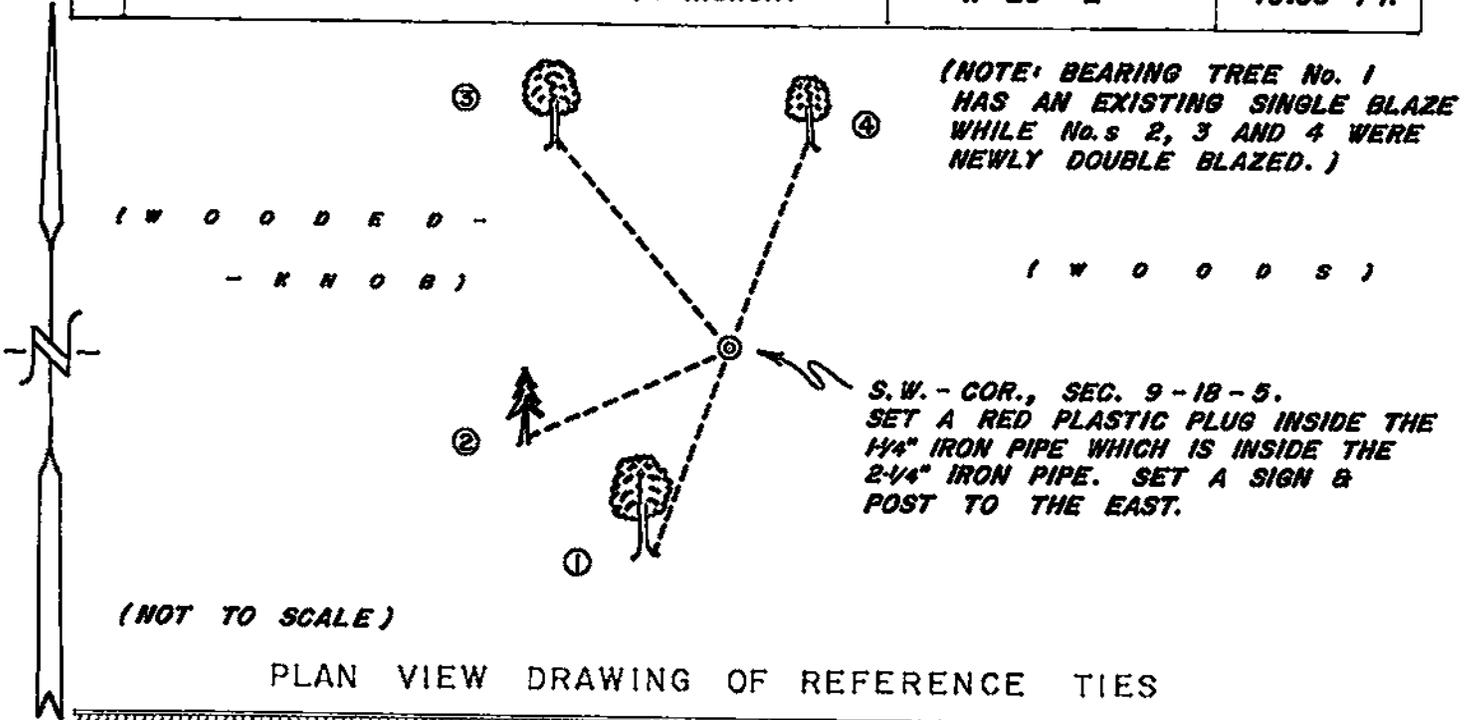


MAP SHOWING DISTANCE AND DIRECTION TO OTHER PUBLIC LAND SURVEY CORNERS USED FOR REESTABLISHING THE CORNER

No new section measurements were made by me at this time. Refer to my 1976 section data and surveys of record made by others since 1976.

I, WILLIAM C. JUNG, COUNTY SURVEYOR
HEREBY CERTIFY THAT THE CORNER LOCATION SHOWN ON THIS RECORD WAS DETERMINED BY ME OR UNDER MY DIRECTION AND CONTROL AND THAT THIS U. S. PUBLIC LAND SURVEY MONUMENT RECORD IS CORRECT AND COMPLETE TO THE BEST OF MY KNOWLEDGE AND BELIEF.

William C. Jung
Signature


3/22/07
Date

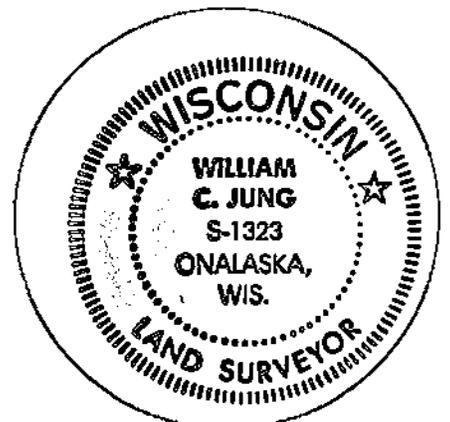

Seal

U. S. PUBLIC LAND SURVEY MONUMENT RECORD

SECTION 9 T 18 N, R 5 W, TOWN OF Farmington
 LA CROSSE COUNTY

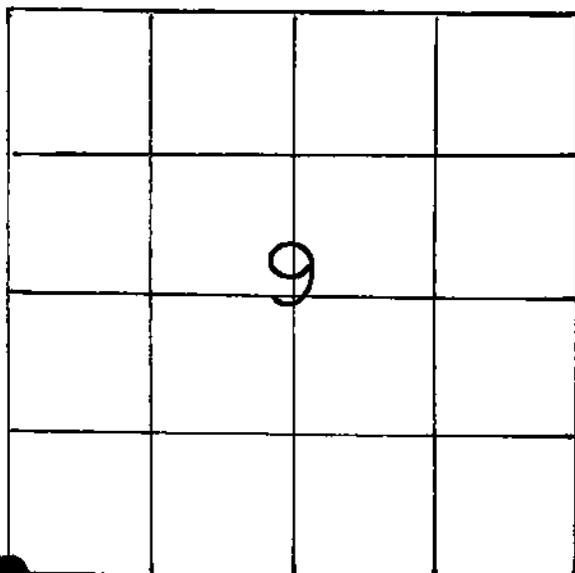

LOCATION OF LANDMARK

Crew: William C. Jung
 Peter F. Follansbee
 Date: November 1, 1990

Describe any record evidence, monument evidence, testimonial evidence or any other material evidence you considered and whether the monument was found or restored through acceptance of an obliterated evidence location.

I found at the corner a pipe that I had set back in September of 1976.


Describe or show any material discrepancy between the location of the restored corner and that of the corner previously restored or reestablished.

None known.

WISCONSIN COORDINATE SYSTEM
North
East
Theta Angle
Horiz. Order
Vert. Order
TYPE OF LANDMARK
Ex. 1 1/4" iron pipe in a 2 1/4" iron pipe
BEARINGS ARE REFERENCED TO

RECORD OF DURABLE WITNESS MONUMENTS
Magnetic

NO	DESCRIPTION	BEARING	DISTANCE
1	14" B.T. w/a new blaze & a blaze from 1976	N17°E	10.17
2	10" "	N60°W	7.93
3	10" "	N74°W	13.42
4	13" single blazed hickory	S16°W	16.86

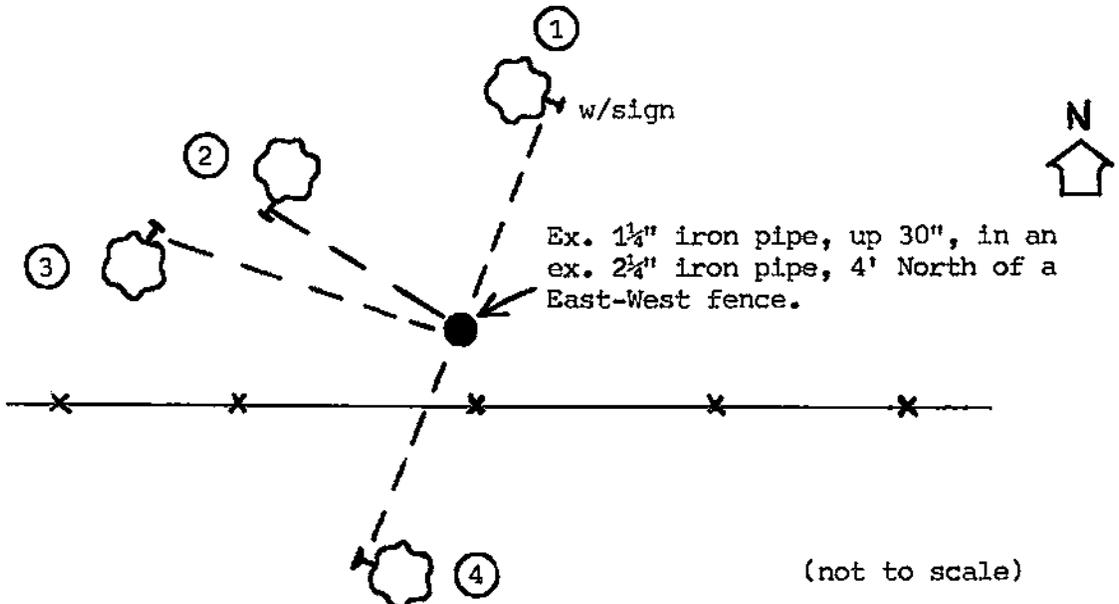

PLAN VIEW DRAWING OF REFERENCE TIES


MAP SHOWING DISTANCE AND DIRECTION TO OTHER PUBLIC LAND SURVEY CORNERS USED FOR REESTABLISHING THE CORNER

No new section measurements made by me at this time. Refer to my 1976 section data.

I, William C. Jung, Deputy County Surveyor,
 HEREBY CERTIFY THAT THE CORNER LOCATION SHOWN ON THIS RECORD
 WAS DETERMINED BY ME OR UNDER MY DIRECTION AND CONTROL AND
 THAT THIS U. S. PUBLIC LAND SURVEY MONUMENT RECORD IS CORRECT
 AND COMPLETE TO THE BEST OF MY KNOWLEDGE AND BELIEF.

William C. Jung
 Signature

February 8, 1991
 Date

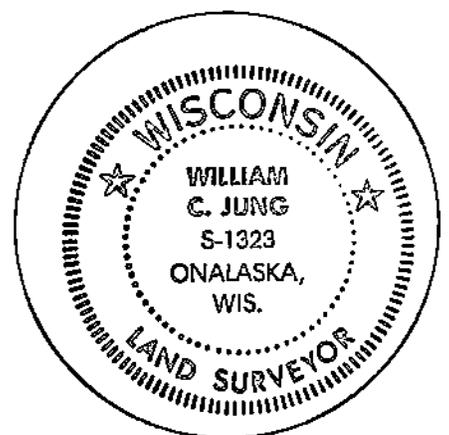

Seal