


U. S. PUBLIC LAND SURVEY MONUMENT RECORD

SECTION 8 T 18 N, R 5 W, TOWN OF Farmington

LA CROSSE COUNTY

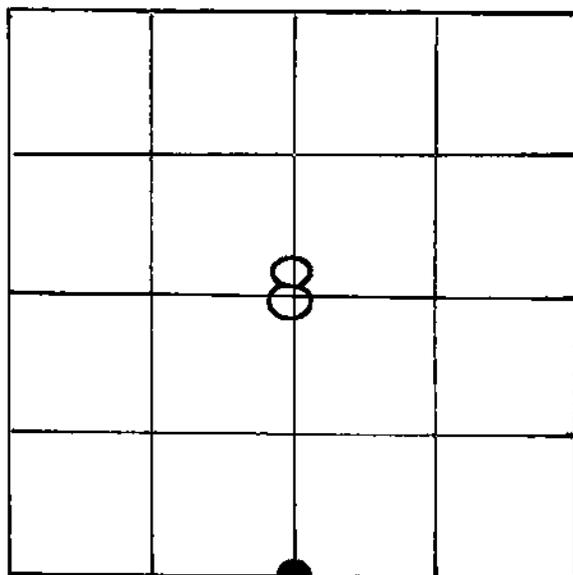

LOCATION OF LANDMARK

WISCONSIN COORDINATE SYSTEM
North
East
Theta Angle
Horiz. Order
Vert. Order
TYPE OF LANDMARK
Brass capped Lunde marker
BEARINGS ARE REFERENCED TO

Crew: William C. Jung
 Peter F. Follansbee
 Daniel Leis

Dates: November 2 and 6, 1990

Describe any record evidence, monument evidence, testimonial evidence or any other material evidence you considered and whether the monument was found or restored through acceptance of an obliterated evidence location.

In September of 1976 I set an iron bar at the occupied corner after accepting the corner as the best available evidence of the original government corner position. I removed the iron bar and replaced it with a Lunde marker. I buried a whiskey bottle with a shell casing on the Northeast side of the Lunde marker. I also set a post and sign West of the Lunde. The marker is on the bank West of the field road.

Describe or show any material discrepancy between the location of the restored corner and that of the corner previously restored or reestablished.

None known.

