


21805082000

U. S. PUBLIC LAND SURVEY MONUMENT RECORD

SECTION 8 T 18 N, R 5 W, TOWN OF FARMINGTON

LA CROSSE COUNTY

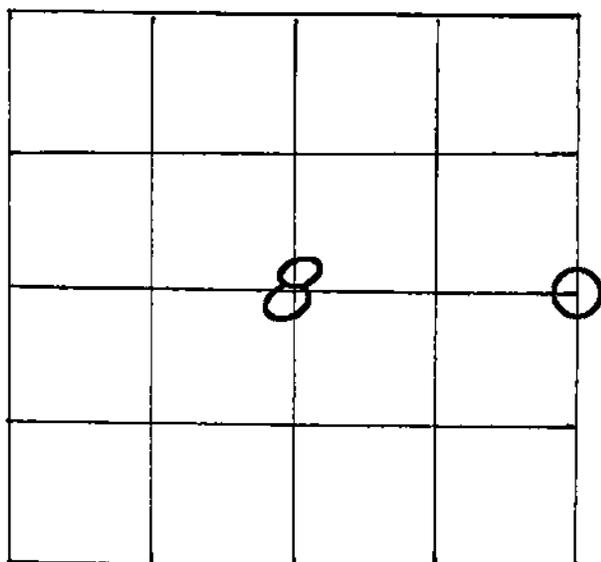

LOCATION OF LANDMARK

CREW: WILLIAM G. JUNG
 PETER F. FOLLANSBEE
 DATE: 1/11/2008

WISCONSIN COORDINATE SYSTEM	
North	748,779.216
East	1,707,434.926
Theta Angle	
Horiz. Order	
Vert. Order	
DATUM:	1983('91)
TYPE OF LANDMARK	
2" (O.D.) x 49" IRON PIPE.	
BEARINGS ARE REFERENCED TO	
GRID NORTH AS PER SECTION DATA.	

Describe any record evidence, monument evidence, testimonial evidence or any other material evidence you considered and whether the monument was found or restored through acceptance of an obliterated evidence location.


In 1976 I surveyed Section 8 and came up with a computed location for this corner as I remonumented five other corners. Over the years surveyors working in Sections 8 and 9 used my computed location as their 1/4 corner. I set an iron pipe at my old 1976 computed corner location. There is no evidence of any occupation in this area of the section.

Describe or show any material discrepancy between the location of the restored corner and that of the corner previously restored or reestablished.

NONE KNOWN.


RECORD OF DURABLE WITNESS MONUMENTS

NO	DESCRIPTION	BEARING	DISTANCE
1	SET A NAIL IN S.W.-SIDE OF AN 18" NORWAY	N 63°W (MAG.)	65.53 FT.
2	SET A NAIL IN W.-SIDE OF A 22-1/2" WHITE PINE	N 14°E (MAG.)	60.76 FT.
3	SET A NAIL IN S.E.-SIDE OF A 6" OAK	N 44°E (MAG.)	69.33 FT.
4	SET A 3/4" x 30" IRON BAR WITH AN ALUMINUM CAP	N 01°06'21"W (GRID)	94.93 FT.

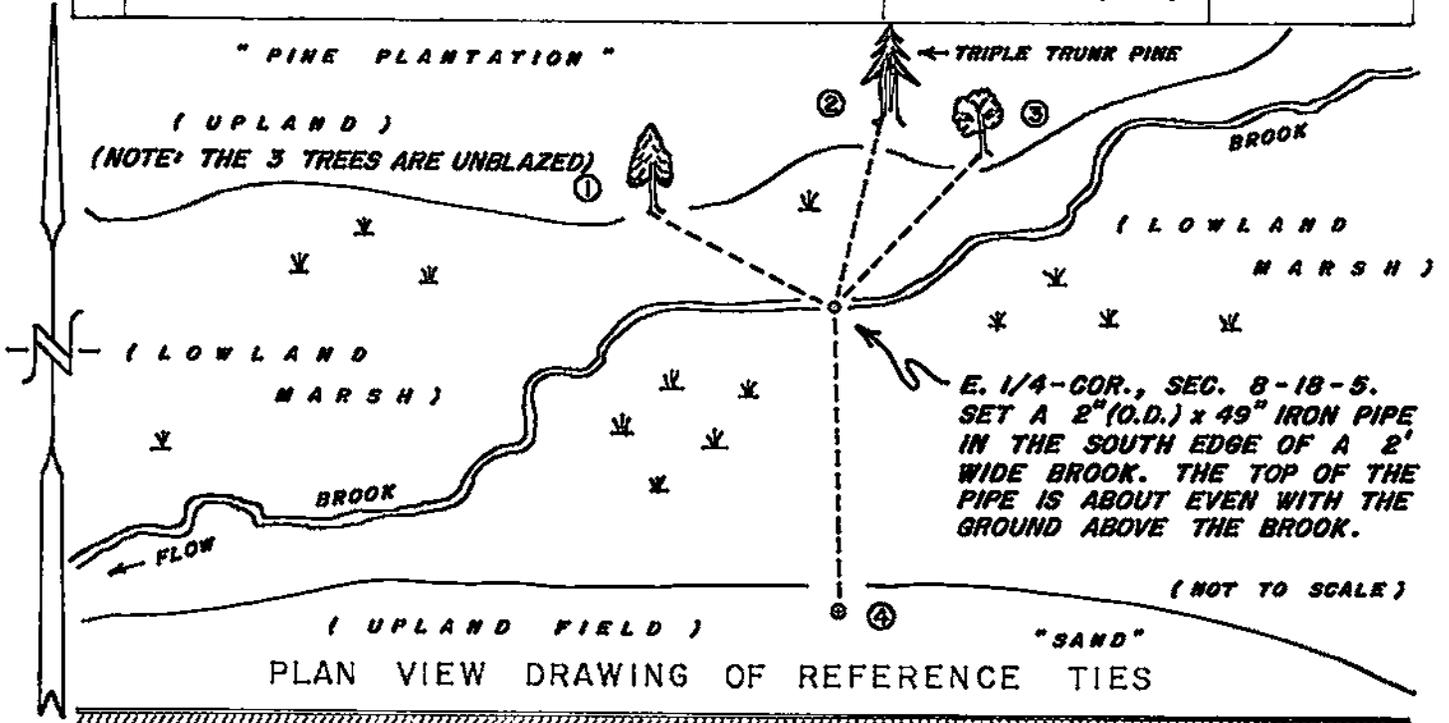

MAP SHOWING DISTANCE AND DIRECTION TO OTHER PUBLIC LAND SURVEY CORNERS USED FOR REESTABLISHING THE CORNER

(GRID FACTOR: 0.9999445)
(NOT TO SCALE)

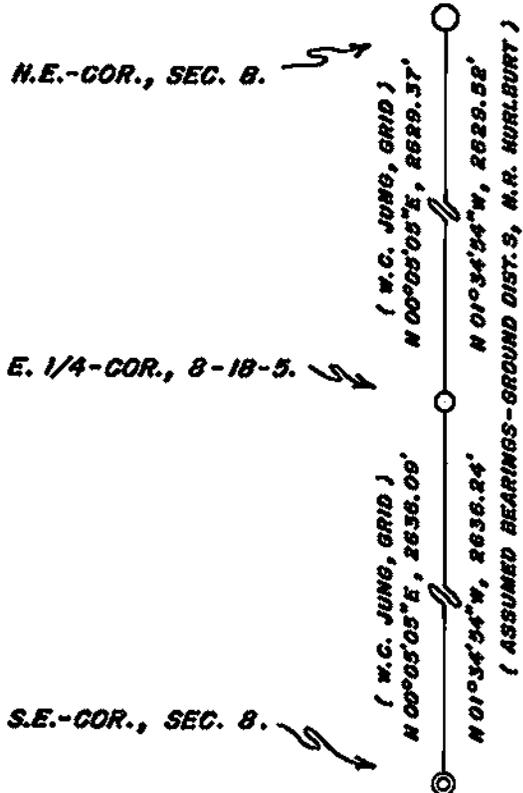

I, WILLIAM G. JUNG, COUNTY SURVEYOR
HEREBY CERTIFY THAT THE CORNER LOCATION SHOWN ON THIS RECORD WAS DETERMINED BY ME OR UNDER MY DIRECTION AND CONTROL AND THAT THIS U. S. PUBLIC LAND SURVEY MONUMENT RECORD IS CORRECT AND COMPLETE TO THE BEST OF MY KNOWLEDGE AND BELIEF.

William G. Jung
Signature

2/1/08
Date



Seal