


U. S. PUBLIC LAND SURVEY MONUMENT RECORD

SECTION 8 T 18 N, R 5 W, TOWN OF Farmington

LA CROSSE COUNTY

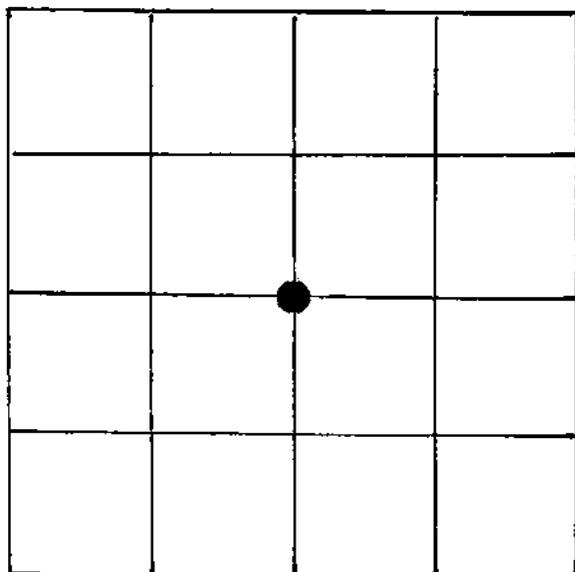

LOCATION OF LANDMARK

WISCONSIN COORDINATE SYSTEM

North

East

Theta Angle

Horiz. Order

Vert. Order

TYPE OF LANDMARK

Brass capped Lunde marker

BEARINGS ARE REFERENCED TO

Crew: William C. Jung
Peter F. Follansbee

Witness: Bob Carrie

Date: November 2, 1990

Describe any record evidence, monument evidence, testimonial evidence or any other material evidence you considered and whether the monument was found or restored through acceptance of an obliterated evidence location.


I set an iron bar at the fence corner at the Center 1/4 corner in September of 1976. I removed the iron bar and replaced it with a Lunde marker. The center of this marker is 0.12' Southeast of the true corner. I buried a bottle with a shell casing on the Southeast side of the marker. The iron bar was on the Southeast side of a new fence post. Bob Carrie said that the new post replaced the old post and also that the iron bar was not disturbed during fencing. A sign was nailed to the new post. All ties are to the center of the Lunde marker.

Describe or show any material discrepancy between the location of the restored corner and that of the corner previously restored or reestablished.

None known.

RECORD OF DURABLE WITNESS MONUMENTS
Magnetic

NO	DESCRIPTION	BEARING	DISTANCE
1	Set 3/4" iron bar	S75°E	32.13
2	P.K. nail in unblazed 10" bearing tree	S75°E	76.80
3	P.K. nail in single blazed 16" burr oak	S20°E	154.50
4	P.K. nail in single blazed 6" oak	S40°W	41.15

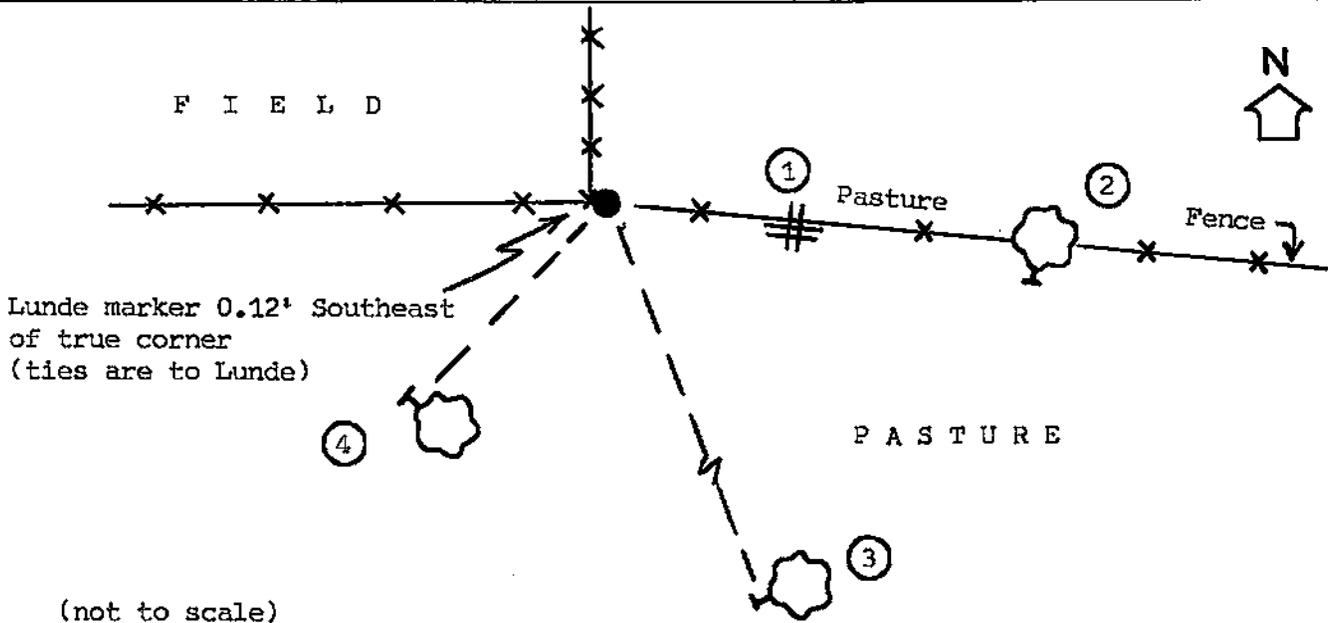

PLAN VIEW DRAWING OF REFERENCE TIES


MAP SHOWING DISTANCE AND DIRECTION TO OTHER PUBLIC LAND SURVEY CORNERS USED FOR REESTABLISHING THE CORNER

No new section measurements made by me at this time. Refer to my 1976 section data.

I, William C. Jung, Deputy County Surveyor,
HEREBY CERTIFY THAT THE CORNER LOCATION SHOWN ON THIS RECORD WAS DETERMINED BY ME OR UNDER MY DIRECTION AND CONTROL AND THAT THIS U. S. PUBLIC LAND SURVEY MONUMENT RECORD IS CORRECT AND COMPLETE TO THE BEST OF MY KNOWLEDGE AND BELIEF.

William C. Jung
Signature

February 7, 1991
Date

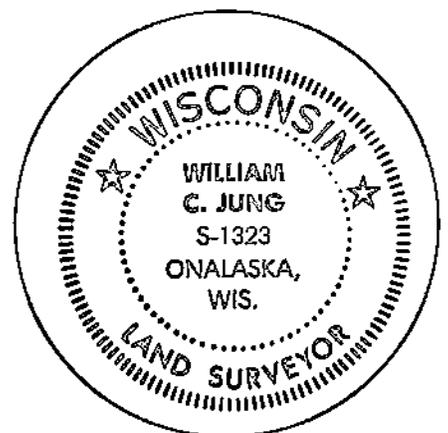

Seal