


## U. S. PUBLIC LAND SURVEY MONUMENT RECORD

SECTION 9 T 18 N, R 5 W, TOWN OF Farmington

LA CROSSE COUNTY

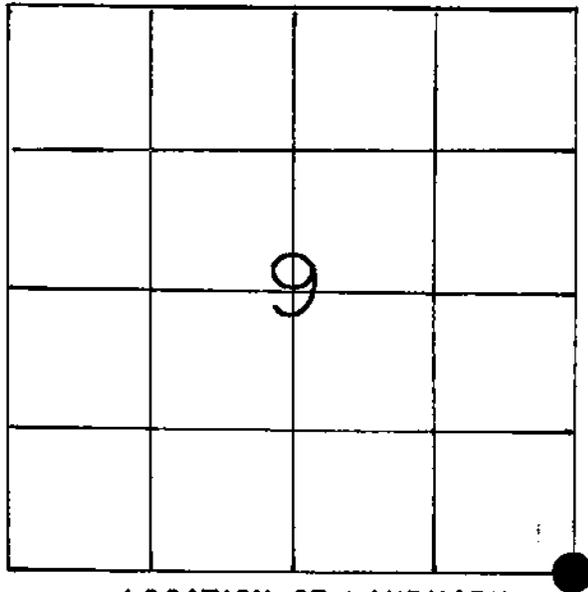

LOCATION OF LANDMARK

## WISCONSIN COORDINATE SYSTEM

North

East

Theta Angle

Horiz. Order

Vert. Order

## TYPE OF LANDMARK

1"x30" iron pipe

## BEARINGS ARE REFERENCED TO

Assumed

Crew: William C. Jung  
Peter F. Follansbee

Date: November 1, 1990

Describe any record evidence, monument evidence, testimonial evidence or any other material evidence you considered and whether the monument was found or restored through acceptance of an obliterated evidence location.


I set the corner at Hurlburt's computed corner location and monumented it with an iron pipe.

Describe or show any material discrepancy between the location of the restored corner and that of the corner previously restored or reestablished.

None known.

RECORD OF DURABLE WITNESS MONUMENTS


NO	DESCRIPTION	BEARING	DISTANCE
1	P.K. nail in power pole West of gravel dwy.	-----	59.84
2	To center of telephone box	-----	60.57
3	Set a 1" iron pipe with a knob on the end, flush and about 1' South of a county highway sign	-----	98.08
4	P.K. nail in double blazed 7" jack oak	Magnetic= N45°W	slope=130.96

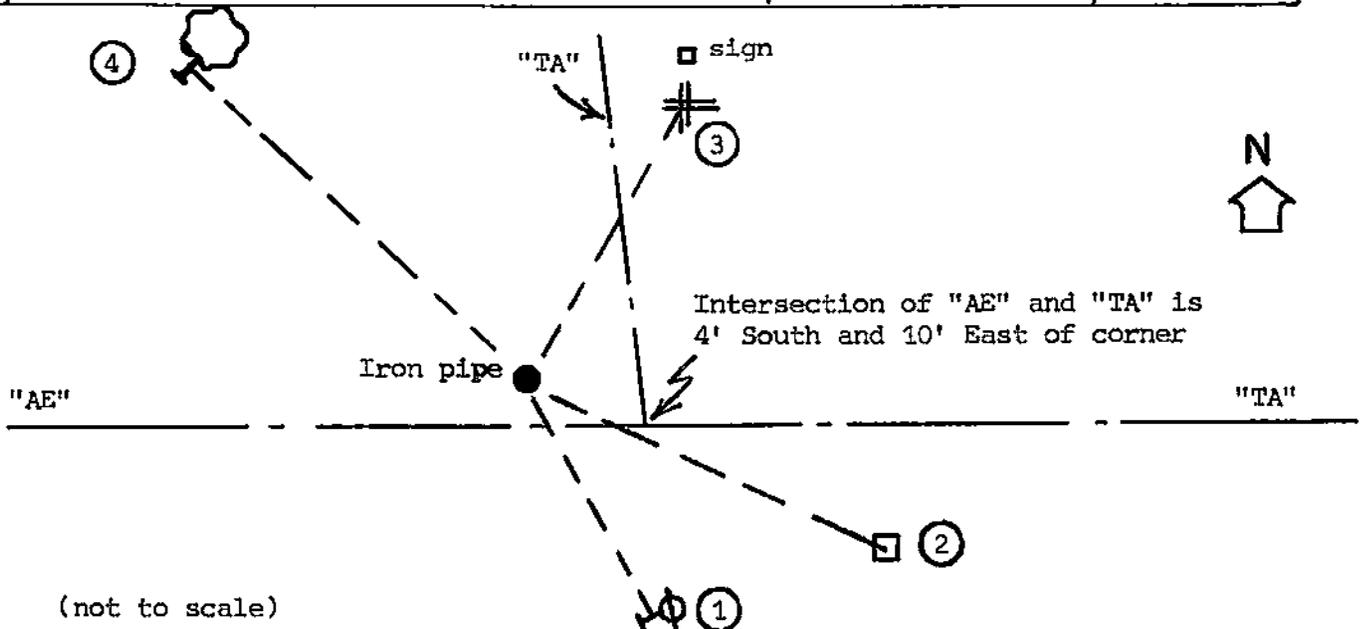

PLAN VIEW DRAWING OF REFERENCE TIES

MAP SHOWING DISTANCE AND DIRECTION TO OTHER PUBLIC LAND SURVEY CORNERS USED FOR REESTABLISHING THE CORNER


(not to scale)

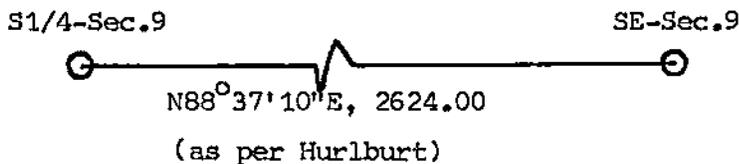

I, William C. Jung, Deputy County Surveyor,  
 HEREBY CERTIFY THAT THE CORNER LOCATION SHOWN ON THIS RECORD  
 WAS DETERMINED BY ME OR UNDER MY DIRECTION AND CONTROL AND  
 THAT THIS U. S. PUBLIC LAND SURVEY MONUMENT RECORD IS CORRECT  
 AND COMPLETE TO THE BEST OF MY KNOWLEDGE AND BELIEF.

William C. Jung  
 Signature

February 8, 1991  
 Date

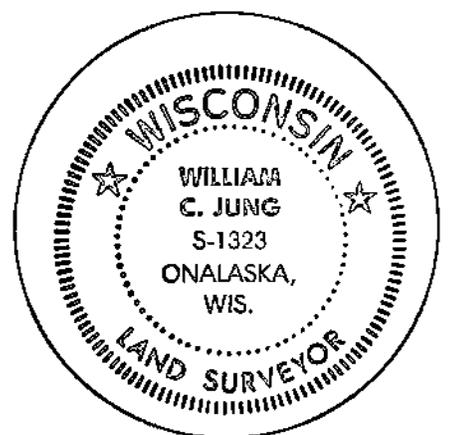

Seal