


U. S. PUBLIC LAND SURVEY MONUMENT RECORD

SECTION 9 T 18 N, R 5 W, TOWN OF Farmington

LA CROSSE COUNTY

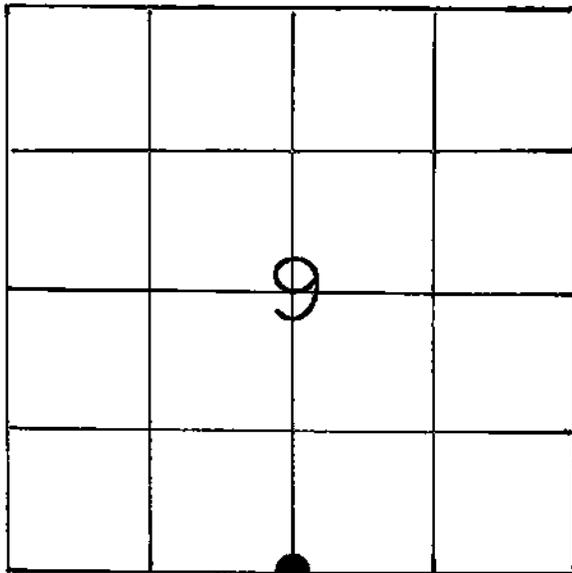

LOCATION OF LANDMARK

WISCONSIN COORDINATE SYSTEM

North

East

Theta Angle

Horiz. Order

Vert. Order

TYPE OF LANDMARK

Brass capped Lunde marker

BEARINGS ARE REFERENCED TO

Assumed

Crew: William C. Jung
Peter F. Follansbee

Date: November 1, 1990

Describe any record evidence, monument evidence, testimonial evidence or any other material evidence you considered and whether the monument was found or restored through acceptance of an obliterated evidence location.


Local residents told Dennis Melichar and Norm Hurlburt of a "rock" at this corner. On June 1 of this year Melichar, Follansbee, and I dug a 9'x9'x4' hole but did not find anything after extensive digging and probing. I set a brass capped Lunde marker at Hurlburt's computed corner location. This point falls about 575' East of where I estimate the old creek used to be. The original notes call for about 577'. The Lunde is in the North shoulder of the road. I buried a bottle with a shell casing on the West side of the marker.

Describe or show any material discrepancy between the location of the restored corner and that of the corner previously restored or reestablished.

None known.

RECORD OF DURABLE WITNESS MONUMENTS

NO	DESCRIPTION	BEARING	DISTANCE
1	P.K. nail in utility pole	S33°E	54.92
2	Set 2" iron pipe, 33' North of centerline	North	20.98
3	P.K. nail in double blazed 17" oak	N7°W	32.35
4	" " 9" oak	N48°W	55.10

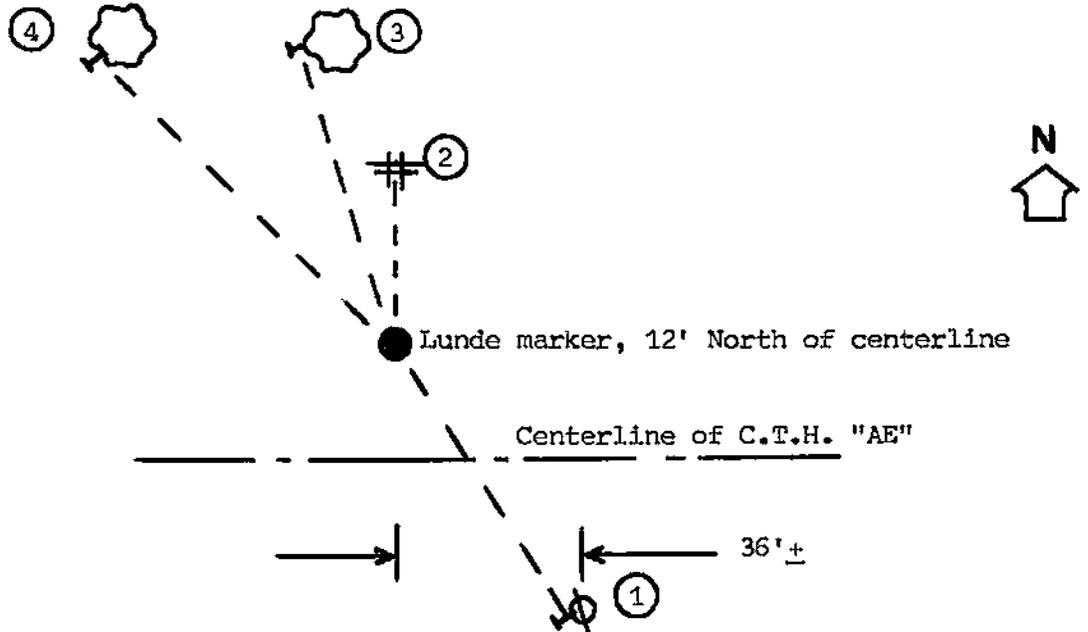


(not to scale)

PLAN VIEW DRAWING OF REFERENCE TIES

MAP SHOWING DISTANCE AND DIRECTION TO OTHER PUBLIC LAND SURVEY CORNERS USED FOR REESTABLISHING THE CORNER

(not to scale)


(Hurlburt measurements)

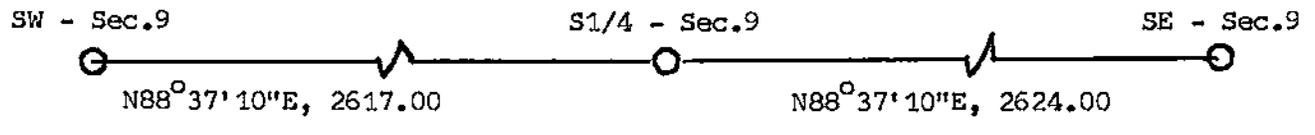

I, William C. Jung, Deputy County Surveyor,
 HEREBY CERTIFY THAT THE CORNER LOCATION SHOWN ON THIS RECORD
 WAS DETERMINED BY ME OR UNDER MY DIRECTION AND CONTROL AND
 THAT THIS U. S. PUBLIC LAND SURVEY MONUMENT RECORD IS CORRECT
 AND COMPLETE TO THE BEST OF MY KNOWLEDGE AND BELIEF.

William C. Jung
 Signature

February 8, 1991
 Date

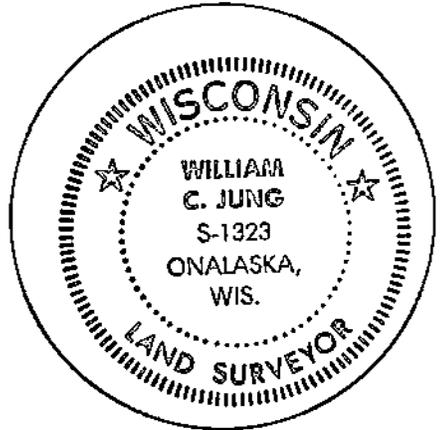

Seal