


21805092000

## U. S. PUBLIC LAND SURVEY MONUMENT RECORD

SECTION 9 T 18 N, R 5 W, TOWN OF FARMINGTON

LA CROSSE COUNTY

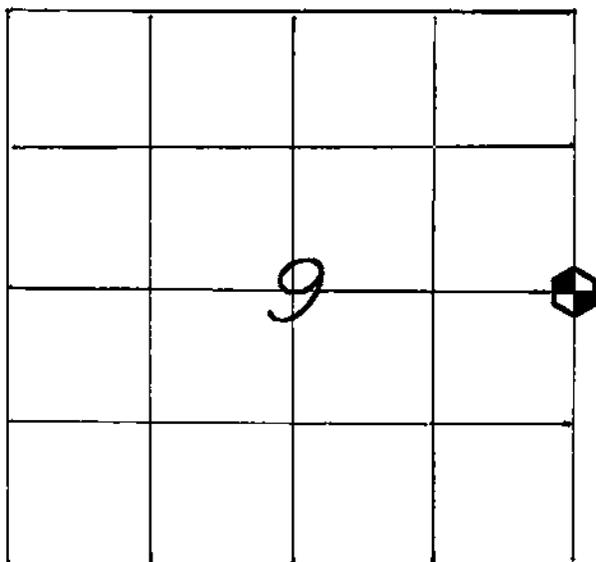

WISCONSIN COORDINATE SYSTEM

North

East

Theta Angle

Horiz. Order

Vert. Order

TYPE OF LANDMARK

BRASS CAP LUNDE MARKER.

BEARINGS ARE REFERENCED TO

## LOCATION OF LANDMARK

CREW: WILLIAM C. JUNG  
 PETER F. FOLLANSBEE  
 DATE: 7/20/1998

Describe any record evidence, monument evidence, testimonial evidence or any other material evidence you considered and whether the monument was found or restored through acceptance of an obliterated evidence location.


After analyzing his section data, Norm Hurlburt and I agreed to accept the old occupied fence corner as the best available evidence of the original government corner position. It would appear that the 1/2 mile to the North is a chain short. This would indicate an error in the original government tally. I removed Hurlburt's nail and replaced it with a brass capped Lunde marker.

Describe or show any material discrepancy between the location of the restored corner and that of the corner previously restored or reestablished.

*NONE KNOWN.*

RECORD OF DURABLE WITNESS MONUMENTS

| NO | DESCRIPTION                           | MAGNETIC BEARING | DISTANCE  |
|----|---------------------------------------|------------------|-----------|
| 1  | SET A NAIL IN S.E.-SIDE OF A 24" OAK  | S 65° W          | 33.15 FT. |
| 2  | SET A NAIL IN S.-SIDE OF A 9-1/2" OAK | N 70° W          | 20.86 FT. |
| 3  | SET A NAIL IN E.-SIDE OF AN 11" OAK   | N 05° W          | 24.72 FT. |
| 4  | SET A NAIL IN N.-SIDE OF A 14" OAK    | EAST             | 4.93 FT.  |

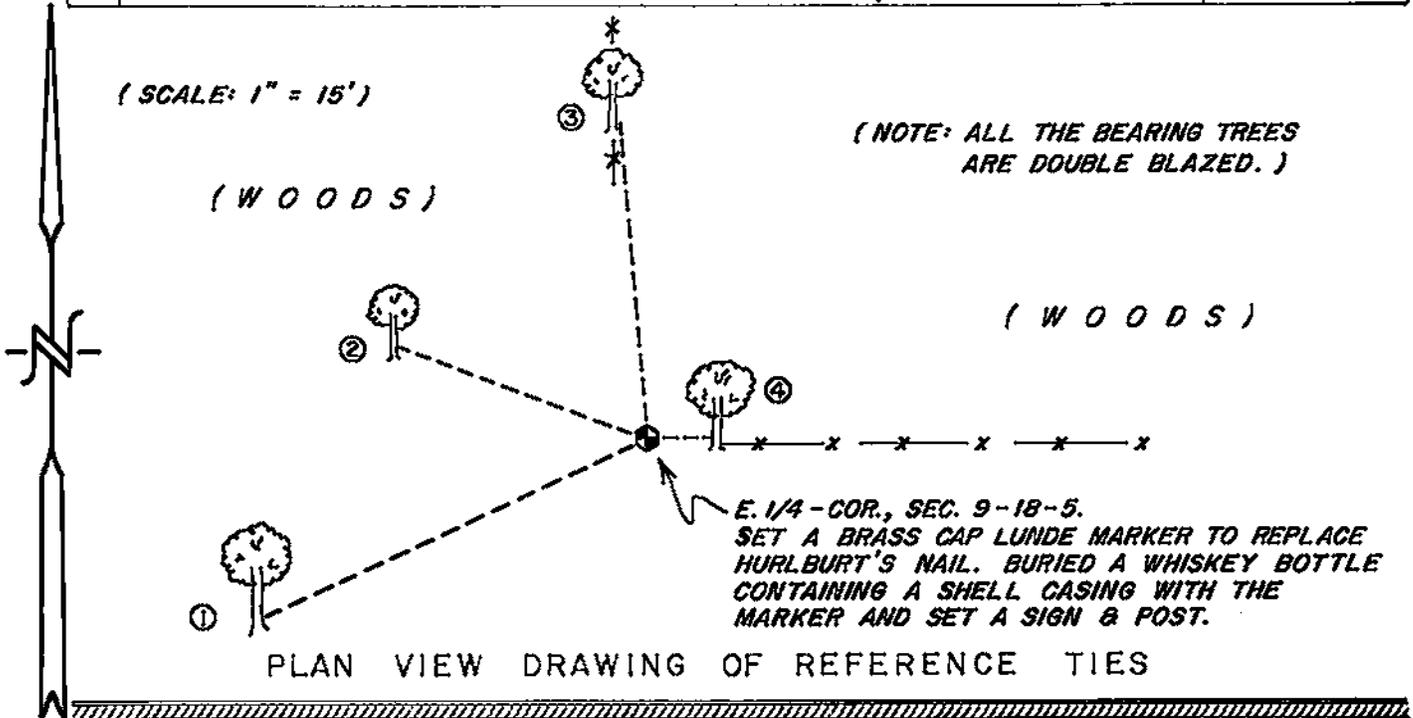


MAP SHOWING DISTANCE AND DIRECTION TO OTHER PUBLIC LAND SURVEY CORNERS USED FOR REESTABLISHING THE CORNER

No section measurements were made by me at this time. The corner location was confirmed through Hurlburt's section survey.

I, WILLIAM C. JUNG, COUNTY SURVEYOR  
 HEREBY CERTIFY THAT THE CORNER LOCATION SHOWN ON THIS RECORD WAS DETERMINED BY ME OR UNDER MY DIRECTION AND CONTROL AND THAT THIS U. S. PUBLIC LAND SURVEY MONUMENT RECORD IS CORRECT AND COMPLETE TO THE BEST OF MY KNOWLEDGE AND BELIEF.

William C. Jung August 20, 1998  
 Signature Date

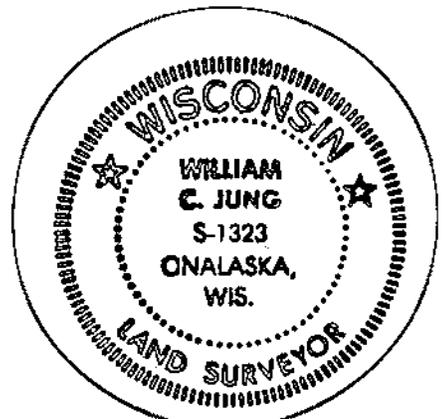

Seal