


21805100000

U. S. PUBLIC LAND SURVEY MONUMENT RECORD

SECTION 11 T 18 N, R 5 W, TOWN OF BURNS

LA CROSSE COUNTY

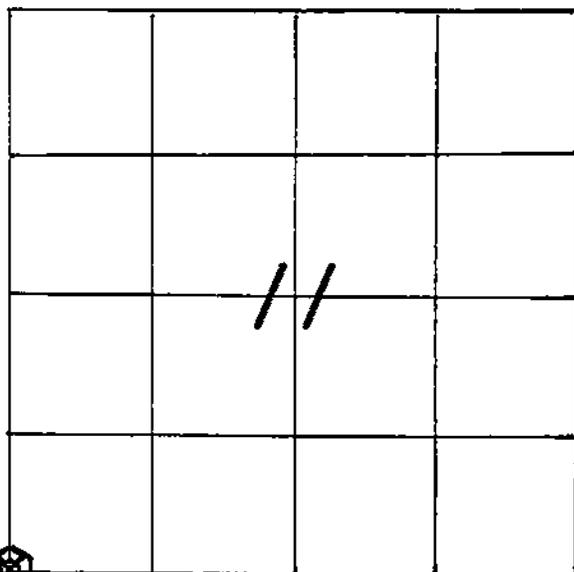

LOCATION OF LANDMARK

CREW: **WILLIAM C. JUNG**
PETER F. FOLLANSBEE
 DATE: **10/01/2002**

WISCONSIN COORDINATE SYSTEM

North **746,015.461**East **1,717,860.543**

Theta Angle

Horiz. Order

Vert. Order

DATUM: **1983('91)**

TYPE OF LANDMARK

BERNTSEN TOP IN STONE PILE.

BEARINGS ARE REFERENCED TO

GRID NORTH AS PER SECTION DATA.

Describe any record evidence, monument evidence, testimonial evidence or any other material evidence you considered and whether the monument was found or restored through acceptance of an obliterated evidence location.

While searching for the corner, we found the original Northeast white oak bearing tree stump. It measured two feet across. Measuring back from the stump, we found a "cairn" at the corner. We set a Berntsen top in a 1½"x24" "square steel pipe", and then set this monument in the middle of the "cairn". The Berntsen top is the corner.

Describe or show any material discrepancy between the location of the restored corner and that of the corner previously restored or reestablished.

NONE KNOWN.

