


21805100020

## U. S. PUBLIC LAND SURVEY MONUMENT RECORD

SECTION 10 T 18 N, R 5 W, TOWN OF FARMINGTON

LA CROSSE COUNTY

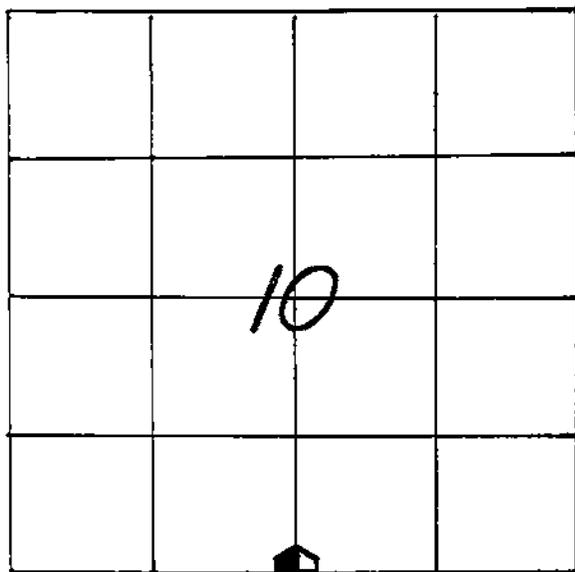

LOCATION OF LANDMARK

CREW: **WILLIAM C. JUNG**  
**PETER F. FOLLANSBEE**  
 DATE: **10/02/2008**

Crew: William C. Jung  
 Peter F. Follansbee  
 Date: 5/14/08

WISCONSIN COORDINATE SYSTEM

North **746,066.220**East **1,715,266.181**

Theta Angle

Horiz. Order

Vert. Order

DATUM: **1983('91)**

TYPE OF LANDMARK

**BRASS CAP LUNDE MARKER.**

BEARINGS ARE REFERENCED TO

**GRID NORTH AS PER SECTION DATA.**

Describe any record evidence, monument evidence, testimonial evidence or any other material evidence you considered and whether the monument was found or restored through acceptance of an obliterated evidence location.

This corner was set "by law" at the single proportionate position. The corner was monumented with a brass capped Lunde marker. While setting the marker I found a buried fieldstone just to the Southwest. I cannot say though whether the stone is the corner or a mere coincidence. Therefore I did not accept it as the corner.


\*\*\*\*\* 5/14/08

As per Mr. Cain's request, we buried the Lunde, down 16 inches. Describe or show any material discrepancy between the location of the restored corner and that of the corner previously restored or reestablished.

**NONE KNOWN.**


RECORD OF DURABLE WITNESS MONUMENTS

NO	DESCRIPTION	GRID BEARINGS	GROUND DIST'S
		BEARING	DISTANCE
1	SET A NAIL IN S.-SIDE OF A 20" OAK	N 34°32'43" W	114.18 FT.
2	SET A NAIL IN S.W.-SIDE OF A 17" OAK	N 04°02'25" W	92.99 FT.
3	SET A NAIL IN A HUMP ON S.W.-SIDE OF A 23" OAK	N 11°59'31" E	98.71 FT.
4	SET A NAIL IN S.-SIDE OF A 16" OAK	N 41°28'46" E	99.54 FT.

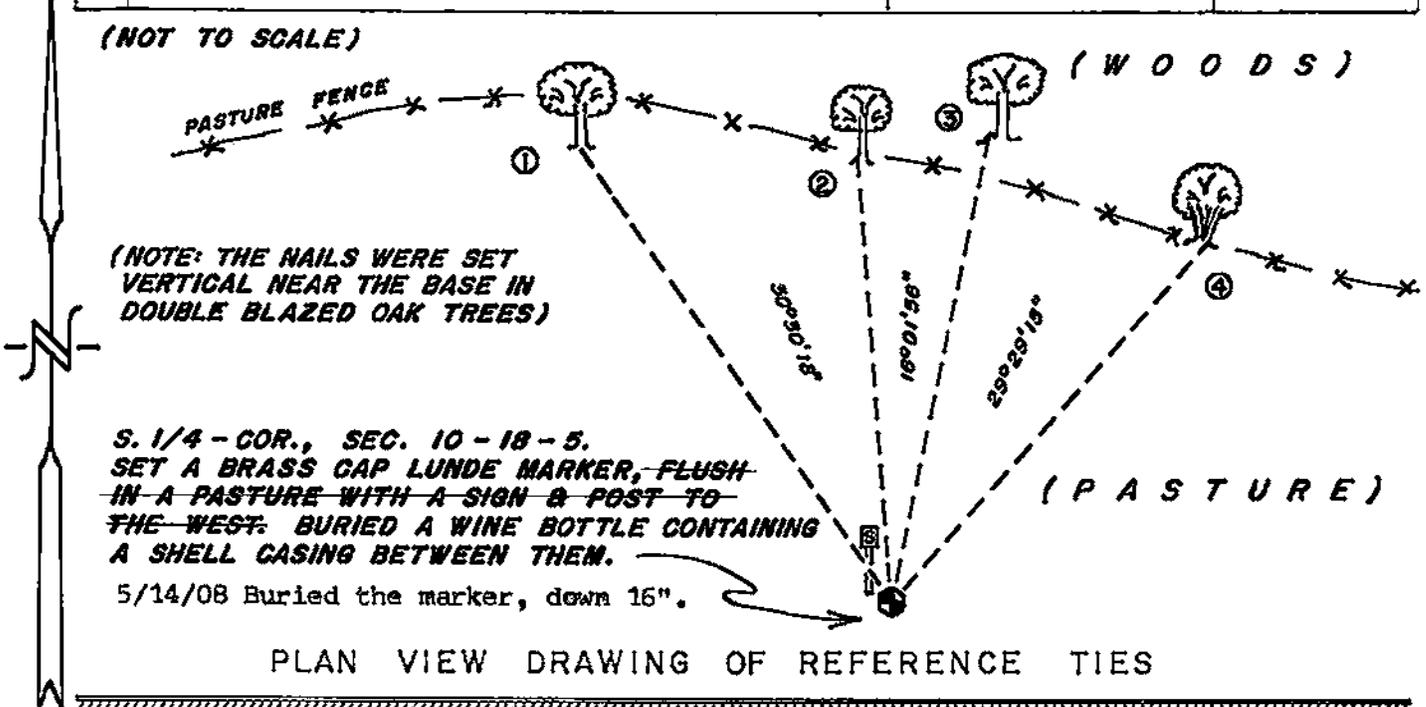

MAP SHOWING DISTANCE AND DIRECTION TO OTHER PUBLIC LAND SURVEY CORNERS USED FOR REESTABLISHING THE CORNER

(GRID BEARINGS & DISTANCE)  
 (GRID FACTOR: 0.9999445)  
 (NOT TO SCALE)

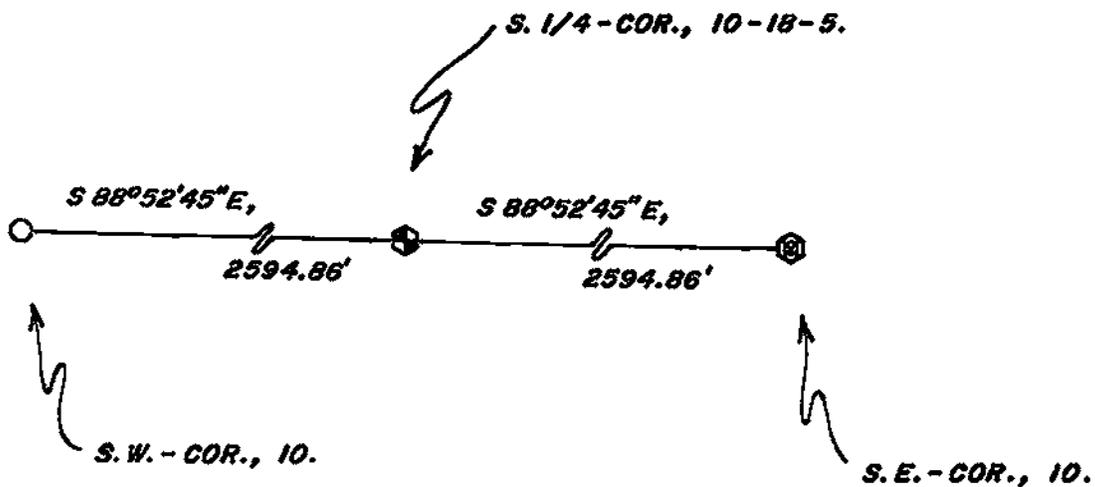

I, WILLIAM C. JUNG, COUNTY SURVEYOR  
 HEREBY CERTIFY THAT THE CORNER LOCATION SHOWN ON THIS RECORD WAS DETERMINED BY ME OR UNDER MY DIRECTION AND CONTROL AND THAT THIS U. S. PUBLIC LAND SURVEY MONUMENT RECORD IS CORRECT AND COMPLETE TO THE BEST OF MY KNOWLEDGE AND BELIEF.

William C. Jung 11/1/02  
 Signature Date

Revised: 6/6/08 *wcj*

