


21805102000

U. S. PUBLIC LAND SURVEY MONUMENT RECORD

SECTION 11 T 18 N, R 5 W, TOWN OF BURNS

LA CROSSE COUNTY

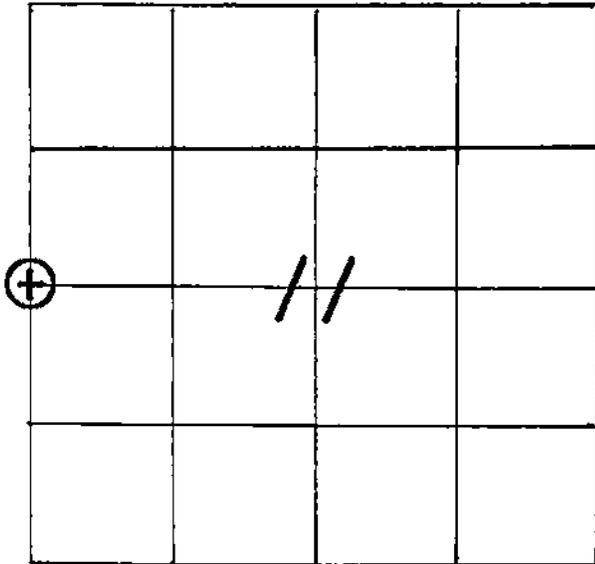

LOCATION OF LANDMARK

CREW: **WILLIAM C. JUNG**
PETER F. FOLLANSBEE
 DATE: **10/09/2002**

WISCONSIN COORDINATE SYSTEM	
North	748,655.255
East	1,717,896.099
Theta Angle	
Horiz. Order	
Vert. Order	
DATUM:	1983('91)
TYPE OF LANDMARK	
3/4" x 30" IRON BAR WITH ALUMINUM CAP.	
BEARINGS ARE REFERENCED TO	
GRID NORTH AS PER SECTION DATA.	

Describe any record evidence, monument evidence, testimonial evidence or any other material evidence you considered and whether the monument was found or restored through acceptance of an obliterated evidence location.

This corner was set "by law" at the single proportionate position. The corner was monumented with an iron bar with a Berntsen cap.

Describe or show any material discrepancy between the location of the restored corner and that of the corner previously restored or reestablished.


NONE KNOWN.

RECORD OF DURABLE WITNESS MONUMENTS

NO	DESCRIPTION	GRID BEARINGS	GRID DISTANCES
		BEARING	DISTANCE
1	SET A 3/4" x 30" IRON BAR WITH RED PLASTIC CAP (BURIED)	S 46°58'34" W	229.73 FT.
2	SET A 3/4" x 30" IRON BAR 3.65' E. OF CENTER 8" ASPEN	S 84°12'26" W	189.27 FT.
3	EX. IRON PIPE AT N.W.-COR. OF A C.S.M. LOT	N 34°53'10" E	447.67 FT.
4	EX. IRON PIPE AT S.W.-COR. OF A C.S.M. LOT	N 46°56'48" E	320.53 FT.

W. 1/4-COR., SEC. 11-18-5.
 SET A 3/4" x 30" IRON BAR WITH
 AN ALUMINUM CAP FLUSH IN A
 LOWER MARSHY AREA. SET A WOOD
 FENCE POST BY THE MARKER AND
 NAILED A SIGN TO IT.


(WOODED
 AREA)

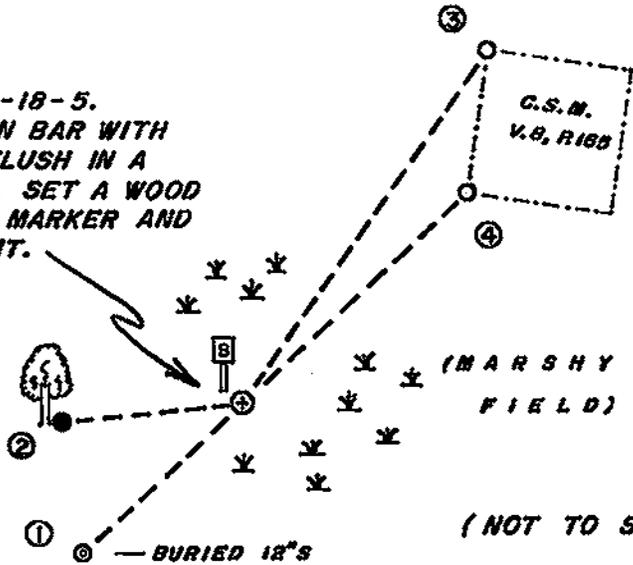

(NOT TO SCALE)

PLAN VIEW DRAWING OF REFERENCE TIES

MAP SHOWING DISTANCE AND DIRECTION TO OTHER PUBLIC LAND SURVEY CORNERS USED FOR REESTABLISHING THE CORNER

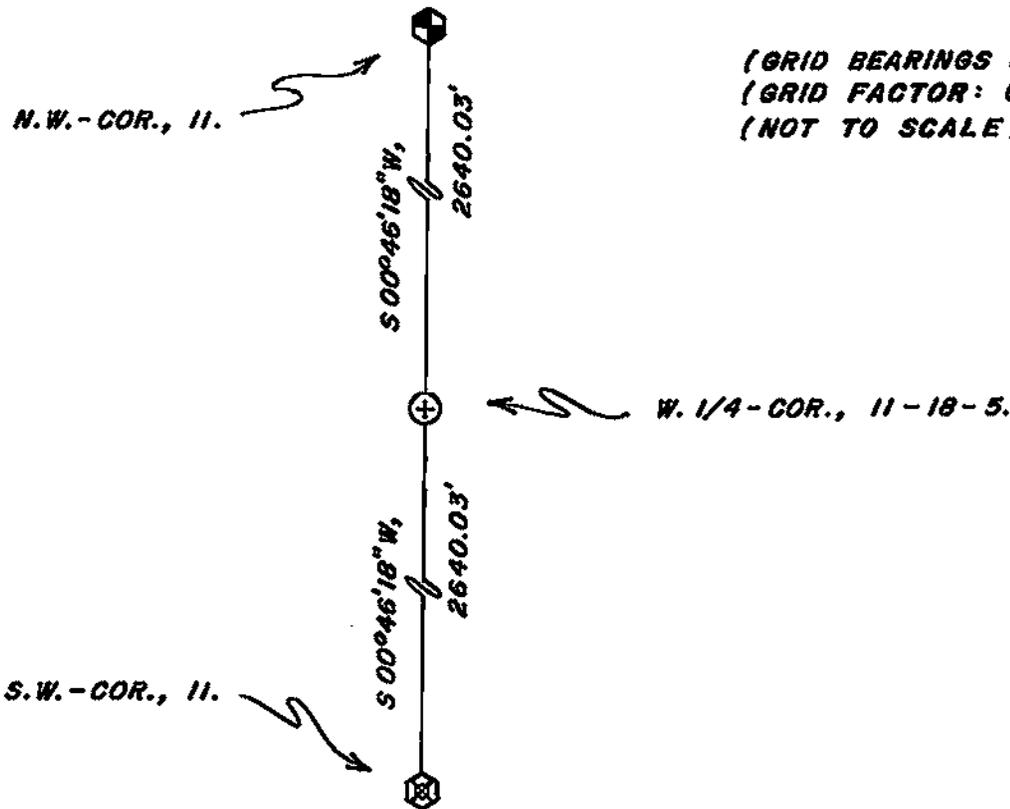

(GRID BEARINGS & DISTANCES)
 (GRID FACTOR: 0.9999445)
 (NOT TO SCALE)

I, WILLIAM C. JUNG, COUNTY SURVEYOR
 HEREBY CERTIFY THAT THE CORNER LOCATION SHOWN ON THIS RECORD
 WAS DETERMINED BY ME OR UNDER MY DIRECTION AND CONTROL AND
 THAT THIS U. S. PUBLIC LAND SURVEY MONUMENT RECORD IS CORRECT
 AND COMPLETE TO THE BEST OF MY KNOWLEDGE AND BELIEF.

William C. Jung 11/5/02
 Signature Date



Seal