


U. S. PUBLIC LAND SURVEY MONUMENT RECORD

SECTION 12 T 18 N, R 5 W, TOWN OF BURNS

LA CROSSE COUNTY

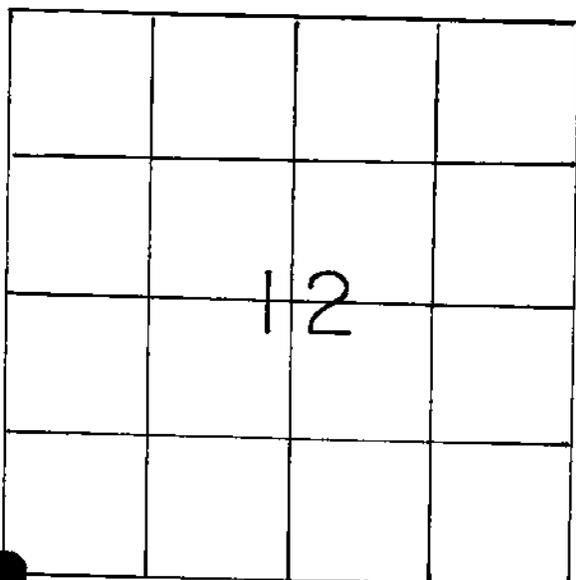

LOCATION OF LANDMARK

Crew: William Jung
Perry Dahl
8/6/85

Crew: William C. Jung
Peter Follansbee
8/6/02

WISCONSIN COORDINATE SYSTEM

North

East

Theta Angle

Horiz. Order

Vert. Order

TYPE OF LANDMARK

BERNTSEN

BEARINGS ARE REFERENCED TO

Assumed

Describe any record evidence, monument evidence, testimonial evidence or any other material evidence you considered and whether the monument was found or restored through acceptance of an obliterated evidence location.

I found a small stone, placed upright, just Northwest of the fence corner. To the Southwest I found a 20" white oak which I believe is an original bearing tree. The original notes called for a 10" white oak, S78W, 6 links(4.38 feet)*. I measured S77W, 4.83 feet to the center of the tree. While digging I found what I believe was old rotted stake discoloration under the stone. I accepted this stone as evidence of the original government corner and replaced it with a Berntsen marker. I set the stone on the ~~North~~^{Northeast} side of the marker.

* 4.38 feet would be to the center of the tree
Describe or show any material discrepancy between the location of the restored corner and that of the corner previously restored or reestablished.

None

Note: On 11/5/85 I took Jim Melton, DNR forester, to this corner. He cored the original white oak bearing tree and estimated its age at 200 years.

