


U. S. PUBLIC LAND SURVEY MONUMENT RECORD

SECTION 11 T 18 N, R 5 W, TOWN OF BURNS

LA CROSSE COUNTY

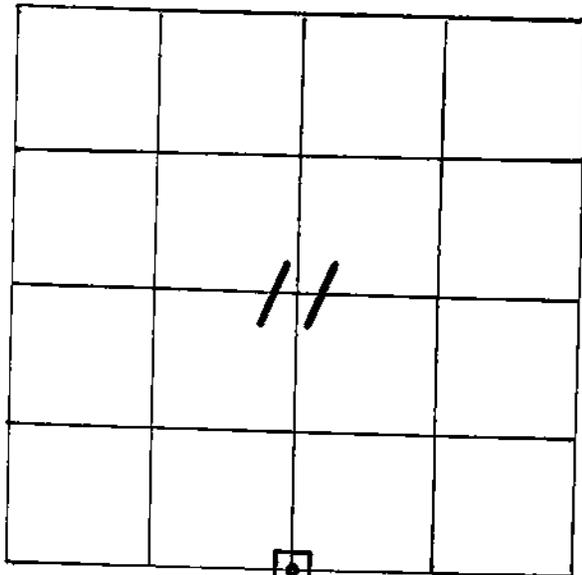

LOCATION OF LANDMARK

CREW: WILLIAM C. JUNG
PETER F. FOLLANSBEE

DATE: 10/01/2002

| | |
|---------------------------------|---------------|
| WISCONSIN COORDINATE SYSTEM | |
| North | 746,000.461 |
| East | 1,720,468.950 |
| Theta Angle | |
| Horiz. Order | |
| Vert. Order | |
| DATUM: | 1983('91) |
| TYPE OF LANDMARK | |
| DRILL HOLE IN EXISTING STONE. | |
| BEARINGS ARE REFERENCED TO | |
| GRID NORTH AS PER SECTION DATA. | |


Describe any record evidence, monument evidence, testimonial evidence or any other material evidence you considered and whether the monument was found or restored through acceptance of an obliterated evidence location.

While searching for the corner we found the original Northeast bearing tree. The tree is a double white oak with half of the tree still standing. The tree measured four feet across at its base. Measuring back from the tree, we found a stone at the corner. The top of the stone was broken off. On it was scribed "S.C.S. 11". This means "South Corner, Section 11". The base of the stone was still solid, so I set a drill hole in its center. I set an iron bar 0.34' to the North as a witness point only. Describe or show any material discrepancy between the location of the restored corner and that of the corner previously restored or reestablished.

NONE KNOWN.

RECORD OF DURABLE WITNESS MONUMENTS
MAGNETIC


| NO | DESCRIPTION | BEARING | DISTANCE |
|----|--|---------|-----------|
| 1 | SET A NAIL IN E.-SIDE OF A 4-1/2" OAK | S 15° W | 16.61 FT. |
| 2 | SET A NAIL IN N.E.-SIDE OF AN 8-1/2" OAK | N 12° W | 35.00 FT. |
| 3 | SET A NAIL IN W.-SIDE OF A 12" OAK | N 50° E | 37.24 FT. |
| 4 | SET A NAIL IN N.W.-SIDE OF REMAINING 18" TRUNK | N 80° E | 55.20 FT. |

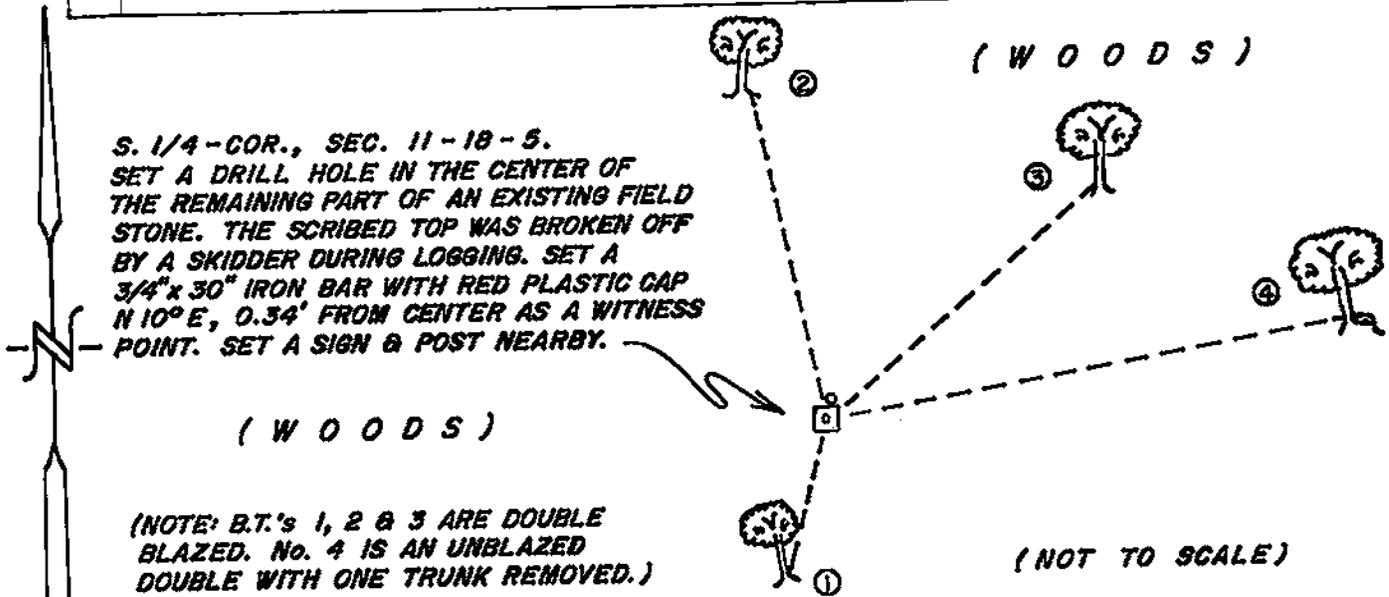

PLAN VIEW DRAWING OF REFERENCE TIES

MAP SHOWING DISTANCE AND DIRECTION TO OTHER PUBLIC LAND SURVEY CORNERS USED FOR REESTABLISHING THE CORNER

(GRID BEARINGS & DISTANCES)
(GRID FACTOR: 0.9999445)
(NOT TO SCALE)

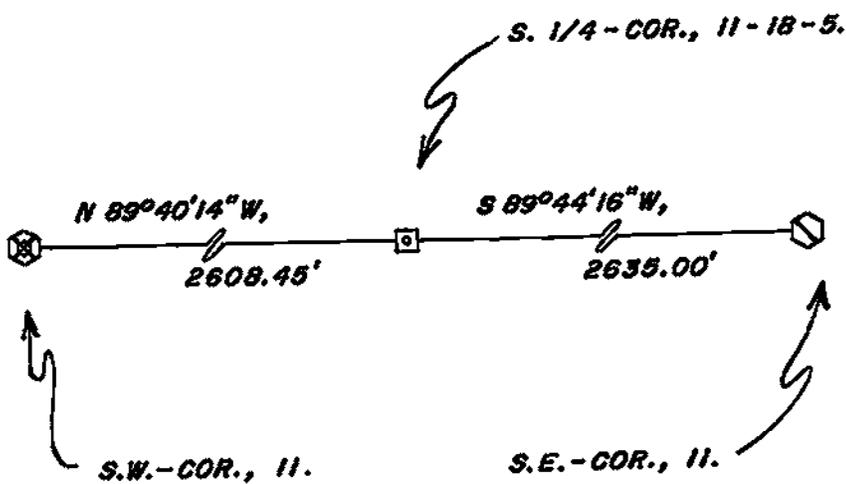

I, WILLIAM C. JUNG, COUNTY SURVEYOR
HEREBY CERTIFY THAT THE CORNER LOCATION SHOWN ON THIS RECORD WAS DETERMINED BY ME OR UNDER MY DIRECTION AND CONTROL AND THAT THIS U. S. PUBLIC LAND SURVEY MONUMENT RECORD IS CORRECT AND COMPLETE TO THE BEST OF MY KNOWLEDGE AND BELIEF.

William C. Jung 11/1/02
Signature Date



Seal