


U. S. PUBLIC LAND SURVEY MONUMENT RECORD

SECTION 12 T 18 N, R 5 W, TOWN OF BURNS

LA CROSSE COUNTY

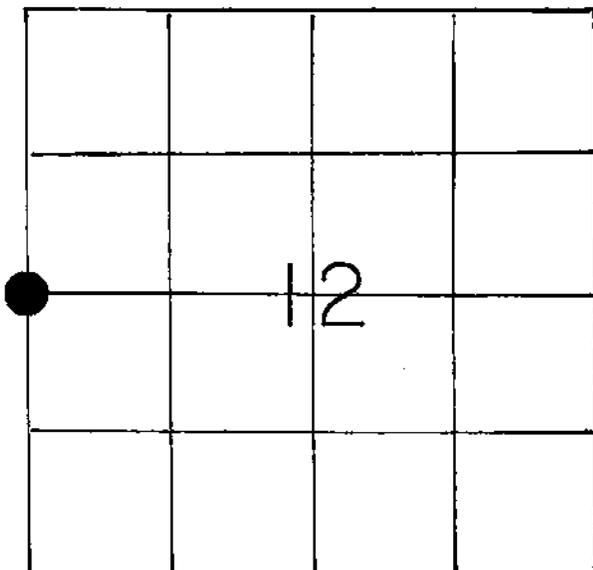

LOCATION OF LANDMARK

Crew: William Jung  
8/9/85

WISCONSIN COORDINATE SYSTEM
North
East
Theta Angle
Horiz. Order
Vert. Order
TYPE OF LANDMARK
BERNTSEN
BEARINGS ARE REFERENCED TO
Assumed

Describe any record evidence, monument evidence, testimonial evidence or any other material evidence you considered and whether the monument was found or restored through acceptance of an obliterated evidence location.

I set the corner on line with the old line fence to the South and halfway between the section corners. After traversing out Section 12 and studying my computations, I believe that this is the best location for the corner. The total North-South distance along the West line of the section is only 7.53 feet longer than the original notes. There is only a 0-12-33 bend at the 1/4 corner. Also based on the evidence that I found at the old school to the East, this highway is a 3 rod road with the road being in the NW1/4 and the East-West

\*(continued below)

Describe or show any material discrepancy between the location of the restored corner and that of the corner previously restored or reestablished.

(continued)

1/4 line the South R/W line. The 1/4 corner as I set it fits this as it does the old school deed.

No discrepancies known.

