


U. S. PUBLIC LAND SURVEY MONUMENT RECORD

SECTION 12 T 18 N, R 5 W, TOWN OF BURNS

LA CROSSE COUNTY

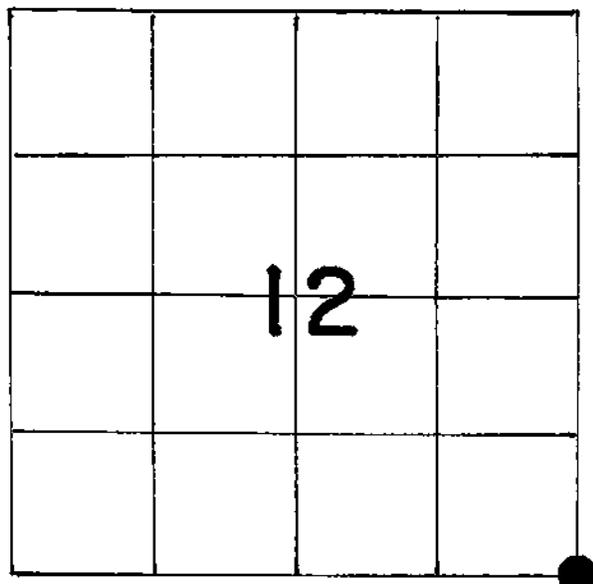

LOCATION OF LANDMARK

WISCONSIN COORDINATE SYSTEM

North

East

Theta Angle

Horiz. Order

Vert. Order

TYPE OF LANDMARK

BERNTSEN

BEARINGS ARE REFERENCED TO

Assumed

Crew: William Jung
8/8/85

Describe any record evidence, monument evidence, testimonial evidence or any other material evidence you considered and whether the monument was found or restored through acceptance of an obliterated evidence location.

I found a 22" white oak, N23W, 14.22 feet from my final corner. The original notes called for a 9" white oak, N20W 21 links (14.24 feet to the center of the tree). After surveying out Section 12, I came to the opinion that the 22" white oak was probably the original tree. Using the tree my final distance to the East 1/4 corner is almost equal to the distance between the East 1/4 and NE corners. Also, my final total along the South line of the section fits the original within about 4 feet. Also too, if one connects the SW and SE corners

*(continued below)

Describe or show any material discrepancy between the location of the restored corner and that of the corner previously restored or reestablished.

(Continued)


with a straight line, the existing fence corner at the S1/16SW is only 1.5 feet or so off line. On a final note, if one compares the difference between the bearing on the North line of the section and a straight line between the SW and SE corners, you would find that it fits the difference between the original variations within 3 minutes. I searched the area thoroughly and found no other evidence of the original corner. Because of rock it was very hard digging.

No discrepancies known.

RECORD OF DURABLE WITNESS MONUMENTS

NO	DESCRIPTION	BEARING	DISTANCE
1	NAIL IN 22" DOUBLE-BLAZED WHITE OAK	N23°W	14.22'
2	P.K. NAIL IN 8" DOUBLE-BLAZED WHITE OAK	S66°E	28.62'
3	P.K. NAIL IN 5" DOUBLE-BLAZED WHITE OAK	N76°E	9.94'
4	P.K. NAIL IN 14" DOUBLE-BLAZED WHITE OAK	N60°E	32.56'


*Magnetic bearings by a hand compass.

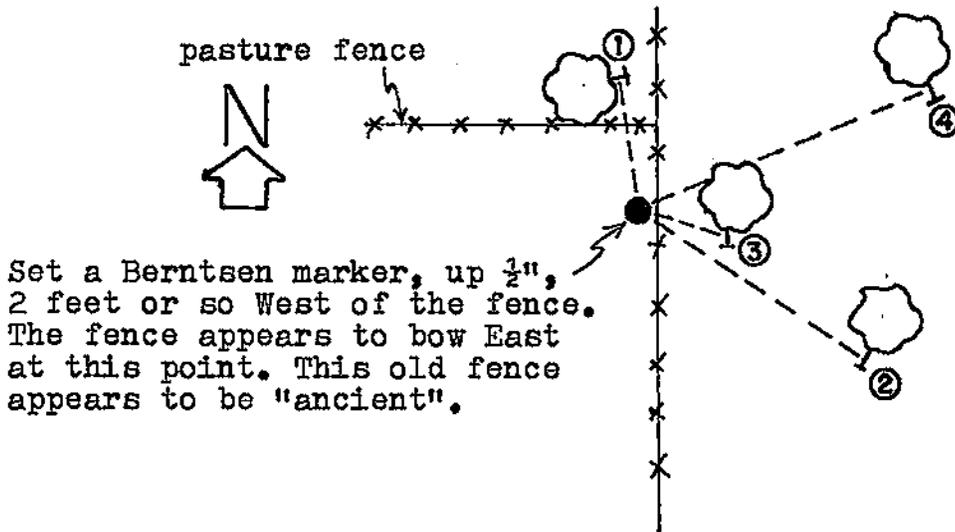

PLAN VIEW DRAWING OF REFERENCE TIES


MAP SHOWING DISTANCE AND DIRECTION TO OTHER PUBLIC LAND SURVEY CORNERS USED FOR REESTABLISHING THE CORNER

(Not to scale)

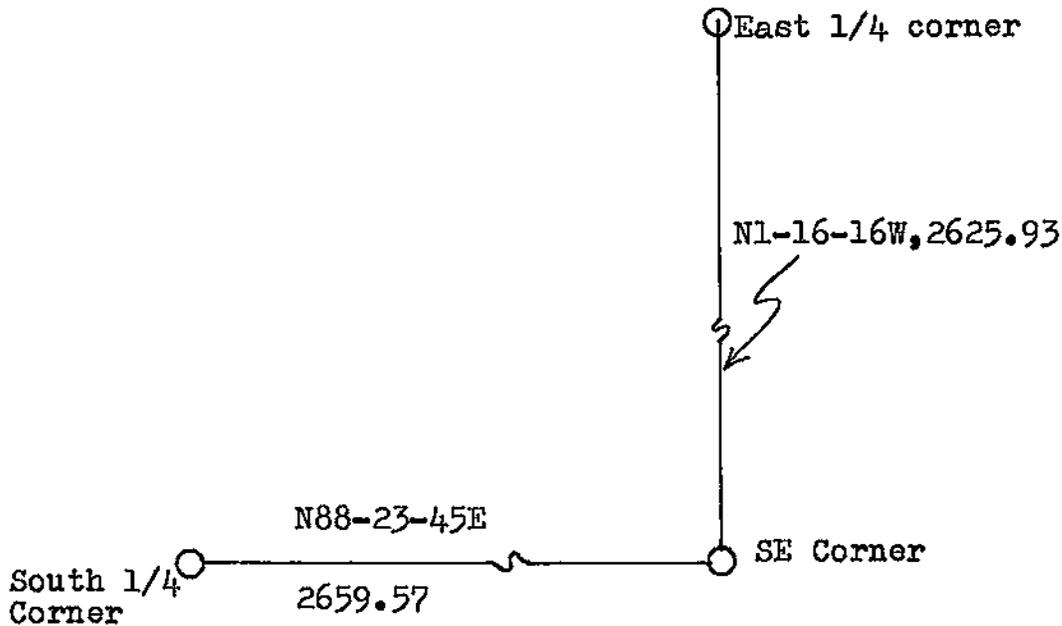

I, William C. Jung, Deputy County Surveyor,
 HEREBY CERTIFY THAT THE CORNER LOCATION SHOWN ON THIS RECORD
 WAS DETERMINED BY ME OR UNDER MY DIRECTION AND CONTROL AND
 THAT THIS U. S. PUBLIC LAND SURVEY MONUMENT RECORD IS CORRECT
 AND COMPLETE TO THE BEST OF MY KNOWLEDGE AND BELIEF.

William C. Jung 8/30/85
 Signature Date

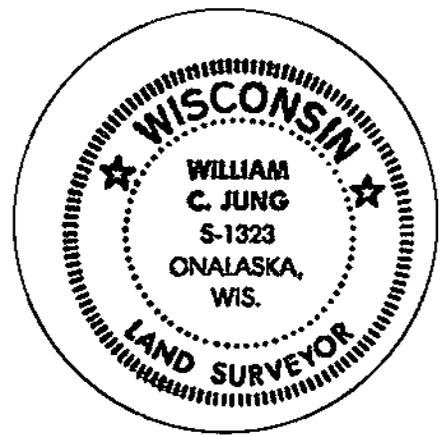

Seal