


U. S. PUBLIC LAND SURVEY MONUMENT RECORD

SECTION 12 T 18 N, R 5 W, TOWN OF BURNS

LA CROSSE COUNTY

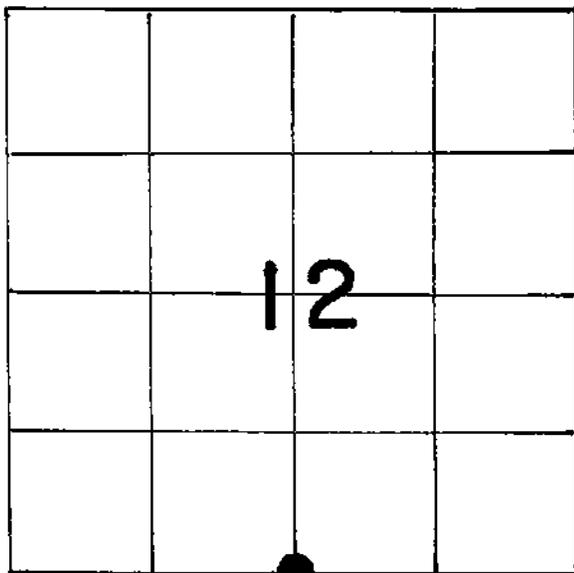

LOCATION OF LANDMARK

WISCONSIN COORDINATE SYSTEM

North

East

Theta Angle

Horiz. Order

Vert. Order

TYPE OF LANDMARK

BERNTSEN

BEARINGS ARE REFERENCED TO

Assumed

Crew: William Jung
Perry Dahl

8/14/85

Describe any record evidence, monument evidence, testimonial evidence or any other material evidence you considered and whether the monument was found or restored through acceptance of an obliterated evidence location.


I accepted the old occupied fence corner as the best available evidence of the original government corner. Marvin Schiller, an old resident of this area, told me that this fence corner has always been at this location and that he never saw a permanent marker such as a stone or pipe.

Describe or show any material discrepancy between the location of the restored corner and that of the corner previously restored or reestablished.

None


RECORD OF DURABLE WITNESS MONUMENTS

NO	DESCRIPTION	BEARING	DISTANCE
1	1½" IRON PIPE	SOUTH ±	9'
2	1½" IRON PIPE	EAST ±	9'
3	—	—	—
4	—	—	—

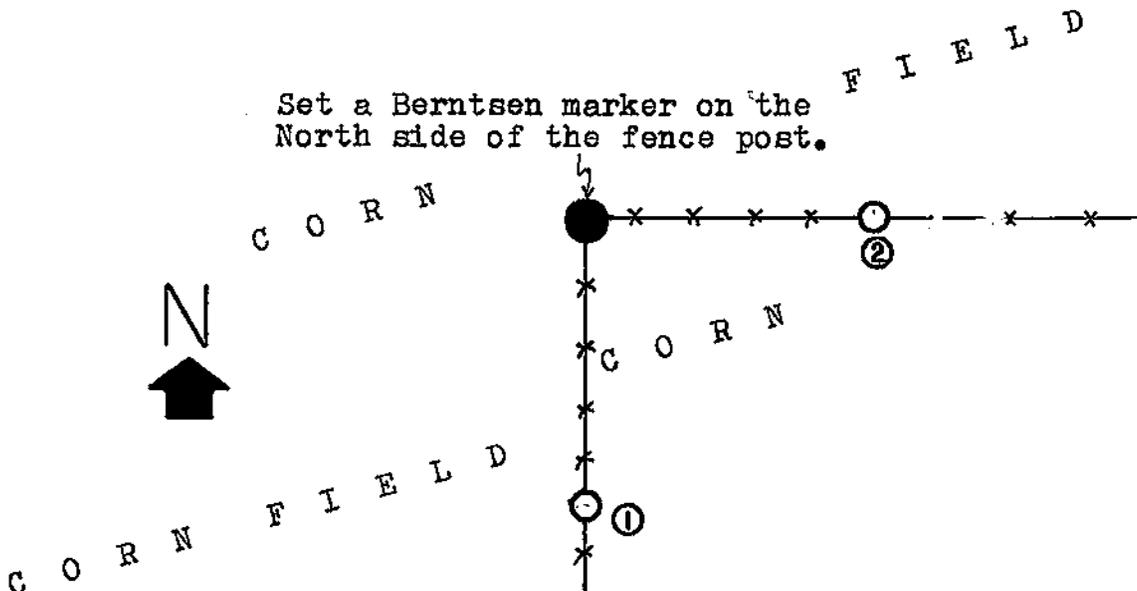

PLAN VIEW DRAWING OF REFERENCE TIES

MAP SHOWING DISTANCE AND DIRECTION TO OTHER PUBLIC LAND SURVEY CORNERS USED FOR REESTABLISHING THE CORNER

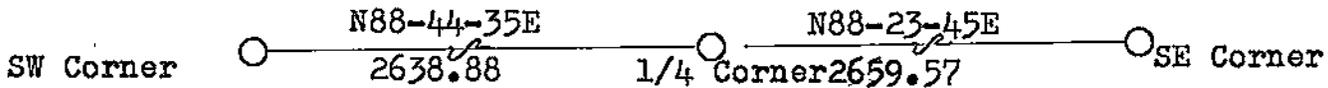

(Not to scale)

I, William C. Jung, Deputy County Surveyor,
 HEREBY CERTIFY THAT THE CORNER LOCATION SHOWN ON THIS RECORD
 WAS DETERMINED BY ME OR UNDER MY DIRECTION AND CONTROL AND
 THAT THIS U. S. PUBLIC LAND SURVEY MONUMENT RECORD IS CORRECT
 AND COMPLETE TO THE BEST OF MY KNOWLEDGE AND BELIEF.

William C. Jung 8/27/85
 Signature Date



Seal