

History of corner establishment since Original Government Survey

WHITESIDE SET ORIGINAL CORNER MARCH 1847.  
FRED HOLDEN WAS AT THIS CORNER IN APRIL 1899.

I, K. DON PEDERSON, do hereby certify that on the 10<sup>TH</sup> day of MAY, 2001, I found (evidence) (no evidence) of the SW corner of SEC. 18, T. 18 N., R. 4 W. Fourth Principal Meridian, and I re-established said corner according to the Wisconsin Statutes as shown and described herein.

Dated this 28<sup>TH</sup> day of MARCH, 2002.

K. Don Pederson

Registered Land Surveyor  
Title




Description of corner and witness monuments, references and accessories used to perpetuate the original or re-established location of this corner:

Witnesses to corner location:

K. DON PEDERSON

PAUL R. CHAFER

NOTE:  
BEARINGS ARE MAGNETIC, AND  
DISTANCES ARE SLOPE.

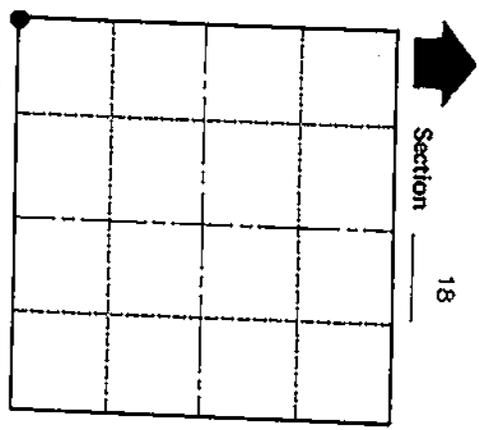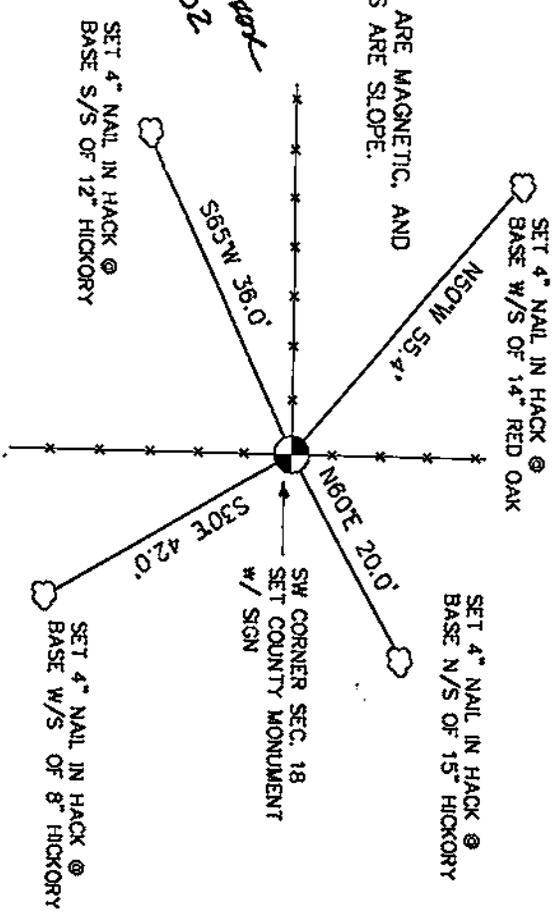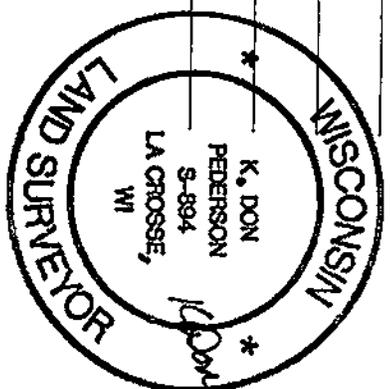

T 18 N R 4W  
WISCONSIN

SURVEY CONTROL ORDER

Horizontal \_\_\_\_\_  
Vertical \_\_\_\_\_

WISCONSIN COORDINATE SYSTEM

Corner	East (X)	North (Y)	Elevation (Z)	Zone
Control Sta. Name				

City/Village/Town

County of

LITTLE FALLS

MONROE