


## U. S. PUBLIC LAND SURVEY MONUMENT RECORD

SECTION 13 T 18 N, R 5 W, TOWN OF BURNS

LA CROSSE COUNTY

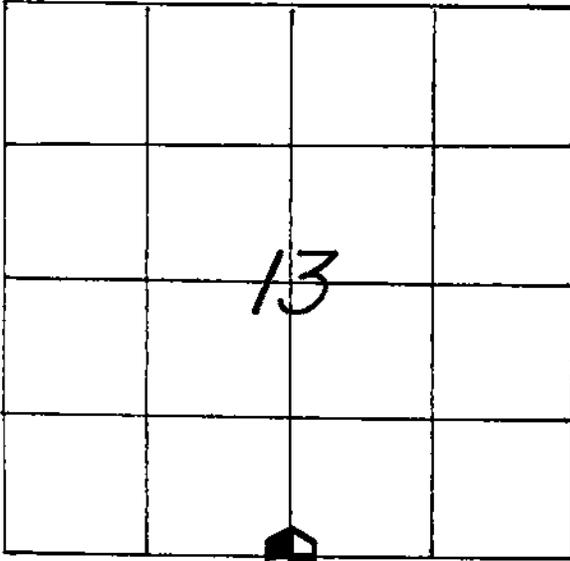

LOCATION OF LANDMARK

CREW: WILLIAM G. JUNG  
 PETER F. FOLLANSBEE  
 DATE: 8/17/2004

WISCONSIN COORDINATE SYSTEM

North

East

Theta Angle

Horiz. Order

Vert. Order

TYPE OF LANDMARK

BRASS CAP LUNDE MARKER.

BEARINGS ARE REFERENCED TO

Describe any record evidence, monument evidence, testimonial evidence or any other material evidence you considered and whether the monument was found or restored through acceptance of an obliterated evidence location.


We searched at length for evidence of the original government corner but found none. Jon Schmitz set a nail at the "lost" or single proportionate position. I found his nail, removed it, and set a brass capped Lunde marker. The Lunde is up a foot or so because of bedrock. The Lunde is about 24 feet East of the fence.

Describe or show any material discrepancy between the location of the restored corner and that of the corner previously restored or reestablished.

**NONE KNOWN.**

RECORD OF DURABLE WITNESS MONUMENTS

NO	DESCRIPTION	MAGNETIC	
		BEARING	DISTANCE
1	SET A NAIL IN S.W.-SIDE OF A 5-1/2" MAPLE	N 60° W	SLOPE = 19.15'
2	SET A NAIL IN S.W.-SIDE OF A 9-1/2" ASPEN	N 20° W	15.80 FT.
3	SET A NAIL IN S.E.-SIDE OF A 6-1/2" MAPLE	N 36° E	20.12 FT.
4	SET A NAIL IN S.W.-SIDE OF A 6" ELM	S 55° E	24.51 FT.

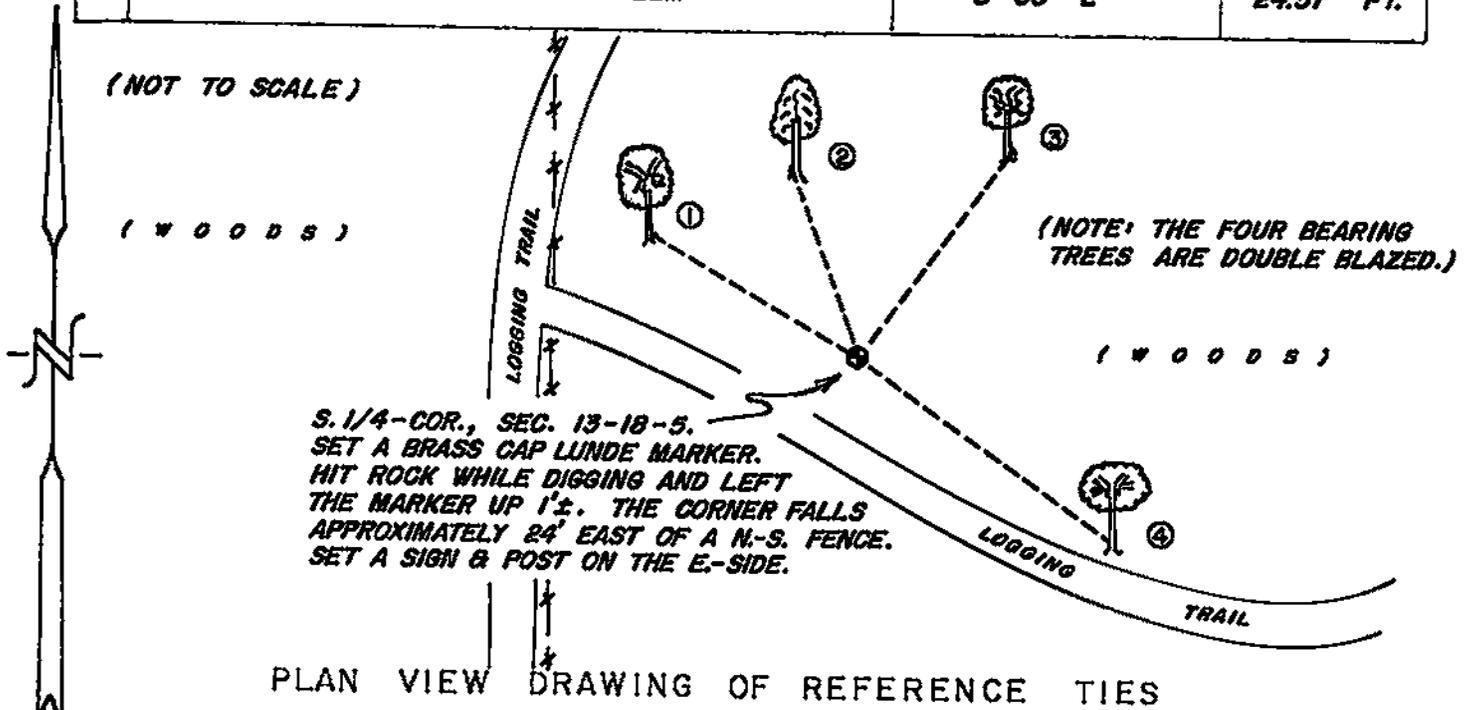


MAP SHOWING DISTANCE AND DIRECTION TO OTHER PUBLIC LAND SURVEY CORNERS USED FOR REESTABLISHING THE CORNER

No section measurements were made by me at this time. Schmitz's section measurements confirmed the location of this corner.

I, WILLIAM C. JUNG, COUNTY SURVEYOR  
 HEREBY CERTIFY THAT THE CORNER LOCATION SHOWN ON THIS RECORD  
 WAS DETERMINED BY ME OR UNDER MY DIRECTION AND CONTROL AND  
 THAT THIS U. S. PUBLIC LAND SURVEY MONUMENT RECORD IS CORRECT  
 AND COMPLETE TO THE BEST OF MY KNOWLEDGE AND BELIEF.

William C. Jung                      8/27/04  
 Signature                                      Date

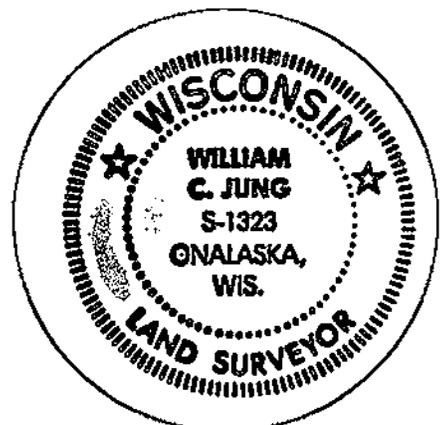

Seal