

CERTIFICATE

CERTIFIED LAND CORNER

No. 78

21805132000 No. 54

I, K. Don Pederson, do hereby certify that on the 8<sup>TH</sup> day of JANUARY, 2002, I found (evidence) (no evidence) of the W 1/4 corner of SEC. 18, T. 18 N., R. 4 W Fourth Principal Meridian, and I re-established said corner according to the Wisconsin Statutes as shown and described hereon.  
 Dated this 28<sup>TH</sup> day of MARCH, 2002.

K. Don Pederson  
 Registered Land Surveyor

History of corner establishment since Original Government Survey

WHITESIDE SET ORIGINAL CORNER NOVEMBER 1845.

Description of corner evidence found:  
 NO ORIGINAL EVIDENCE FOUND  
 SET CORNER PROPORTIONED BETWEEN SW AND NW CORNERS OF SECTION.




Description of corner and witness monuments, references and accessories used to perpetuate the original or re-established location of this corner:

Witnesses to corner location:

K. DON PEDERSON

PAUL R. CHAFER

SURVEY CONTROL ORDER	
Horizontal	
Vertical	
Corner	East (X)
Control Sta. Name	

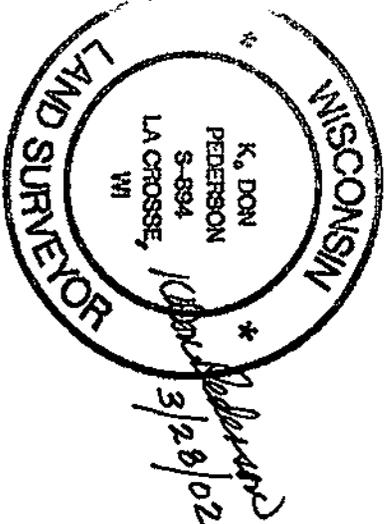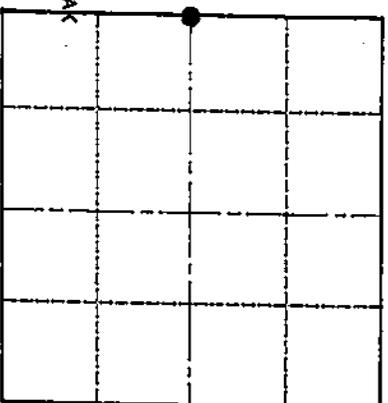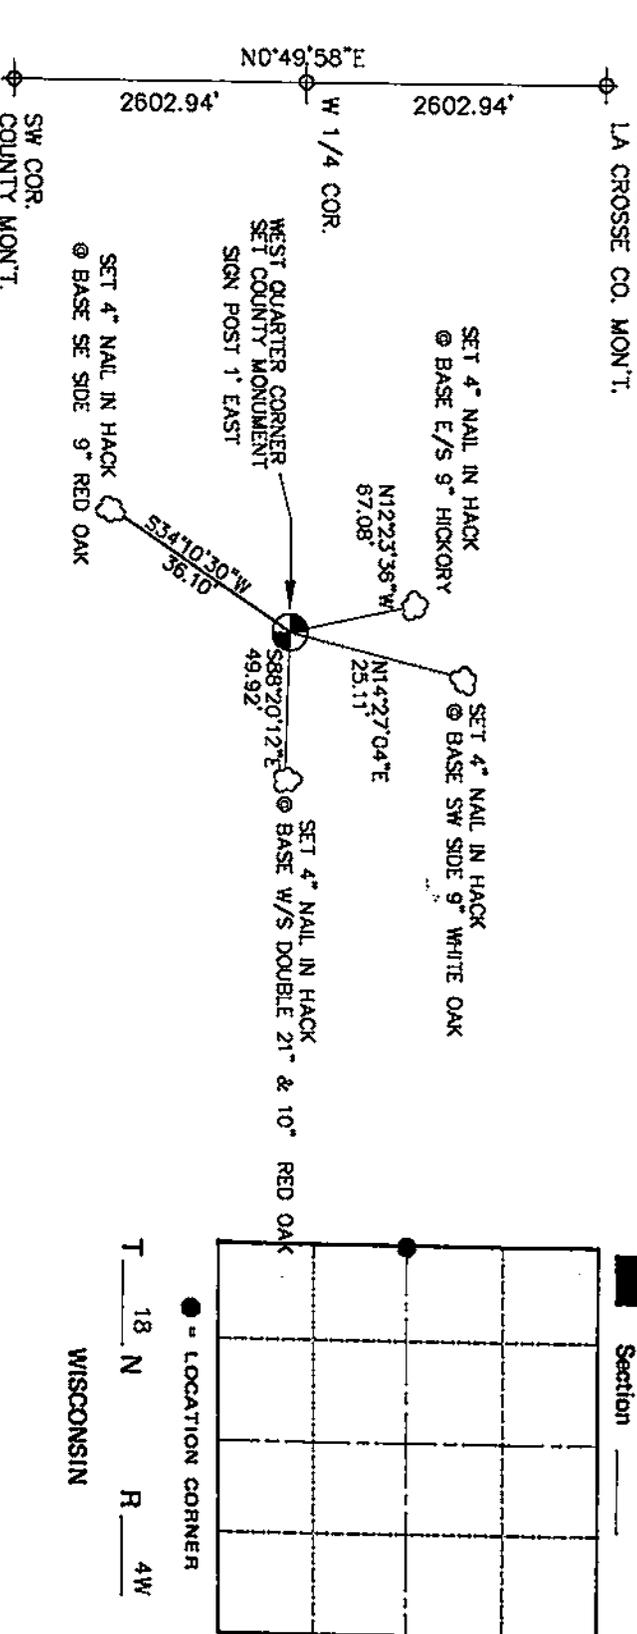

WISCONSIN COORDINATE SYSTEM

City, Village or Town

LITTLE FALLS

County of

MONROE

WISCONSIN