


U. S. PUBLIC LAND SURVEY MONUMENT RECORD

SECTION 23 T 18 N, R 5 W, TOWN OF BURNS

LA CROSSE COUNTY

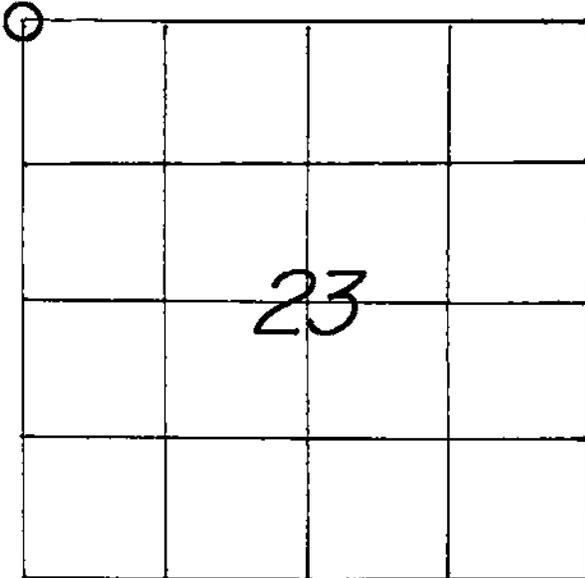

WISCONSIN COORDINATE SYSTEM

North 740,773.921

East 1,717,828.367

Theta Angle

Horiz. Order

Vert. Order

DATUM: 1983('91)

TYPE OF LANDMARK
EXISTING IRON PIPE.BEARINGS ARE REFERENCED TO
GRID NORTH AS PER SECTION DATA.

LOCATION OF LANDMARK

CREW: WILLIAM G. JUNG
PETER F. FOLLANSBEE
DATE: 1/07/2002

Describe any record evidence, monument evidence, testimonial evidence or any other material evidence you considered and whether the monument was found or restored through acceptance of an obliterated evidence location.

I found an iron pipe at the corner that had been used in previous survey work. After surveying out Section 23, I accepted this iron pipe as the best available evidence of the original government corner position.

Describe or show any material discrepancy between the location of the restored corner and that of the corner previously restored or reestablished.

NONE KNOWN.

