


## U. S. PUBLIC LAND SURVEY MONUMENT RECORD

SECTION 22 T 18 N, R 5 W, TOWN OF FARMINGTON

LA CROSSE COUNTY

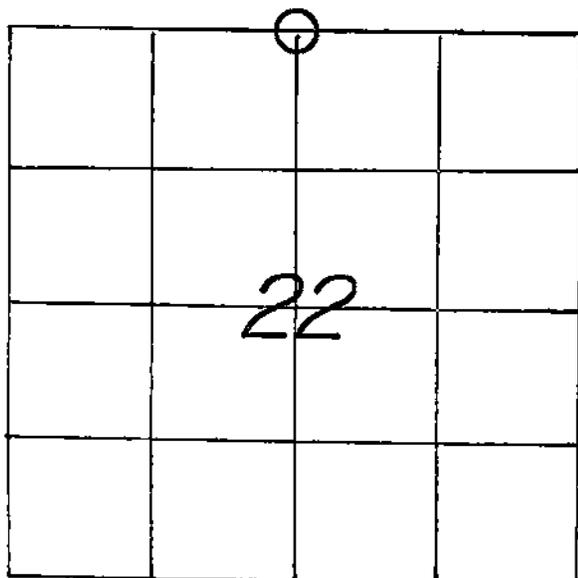

LOCATION OF LANDMARK

CREW: WILLIAM C. JUNG  
 PETER F. FOLLANSBEE  
 DATE: 9/29/2004

WISCONSIN COORDINATE SYSTEM	
North	740,814.424
East	1,715,226.514
Theta Angle	
Horiz. Order	
Vert. Order	
DATUM:	1983('91)
TYPE OF LANDMARK	
IRON PIPE.	
BEARINGS ARE REFERENCED TO	
GRID NORTH AS PER SECTION DATA.	

Describe any record evidence, monument evidence, testimonial evidence or any other material evidence you considered and whether the monument was found or restored through acceptance of an obliterated evidence location.

N.E. Whiteside set a wood post at the original government corner in March of 1847. Since that time I believe that a county surveyor worked in this area at least a 100 years ago, but I cannot verify that as all the old county surveyor books are lost except one. At the corner I found both of Whiteside's bearing trees. Considering their age, the two white oaks are in very good condition. I set a pipe at the corner using these two trees and Whiteside's original calls. I found no evidence of the original

Describe or show any material discrepancy between the location of the restored corner and that of the corner previously restored or reestablished. post.

**NONE KNOWN.**

(over)

