


21805152000

U. S. PUBLIC LAND SURVEY MONUMENT RECORD

SECTION 14 T 18 N, R 5 W, TOWN OF BURNS

LA CROSSE COUNTY

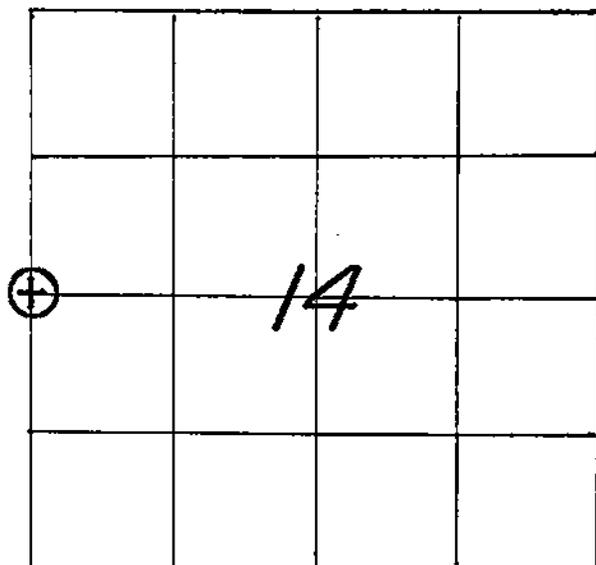

LOCATION OF LANDMARK

CREW: WILLIAM C. JUNG
 PETER F. FOLLANSBEE
 DATE: 10/07/2002

WISCONSIN COORDINATE SYSTEM	
North	743,391.350
East	1,717,840.433
Theta Angle	
Horiz. Order	
Vert. Order	
DATUM:	1983('91)
TYPE OF LANDMARK	
3/4" x 30" IRON BAR WITH ALUMINUM CAP.	
BEARINGS ARE REFERENCED TO	
GRID NORTH AS PER SECTION DATA.	

Describe any record evidence, monument evidence, testimonial evidence or any other material evidence you considered and whether the monument was found or restored through acceptance of an obliterated evidence location.


After resurveying this section line, I accepted the old occupied corner as the best available evidence of the original government corner position and monumented it with an iron bar with a Berntsen cap

Describe or show any material discrepancy between the location of the restored corner and that of the corner previously restored or reestablished.


NONE KNOWN.

RECORD OF DURABLE WITNESS MONUMENTS
MAGNETIC

NO	DESCRIPTION	BEARING	DISTANCE
1	SET A P.K. NAIL IN E.-SIDE OF A 25" OAK	NORTH ±	2.60 FT.
2	SET A NAIL IN N.E.-SIDE OF A 15" WHITE OAK	S 55° E	SLOPE=66.65'
3	SET A 3/4" X 30" IRON BAR WITH A RED PLASTIC CAP	S 25° E	13.38 FT.
4	SET A NAIL IN S.E.-SIDE OF A 14" WHITE OAK	S 20° W	44.12 FT.

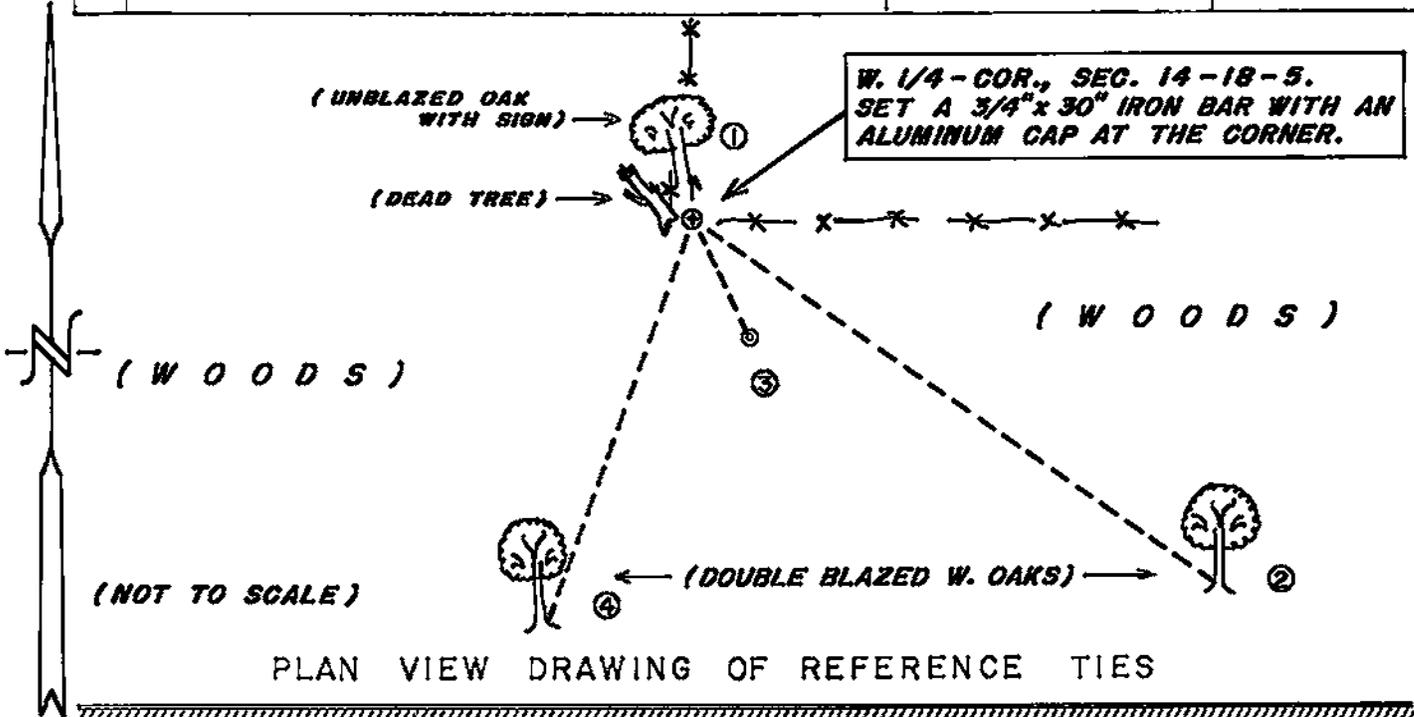

MAP SHOWING DISTANCE AND DIRECTION TO OTHER PUBLIC LAND SURVEY CORNERS USED FOR REESTABLISHING THE CORNER

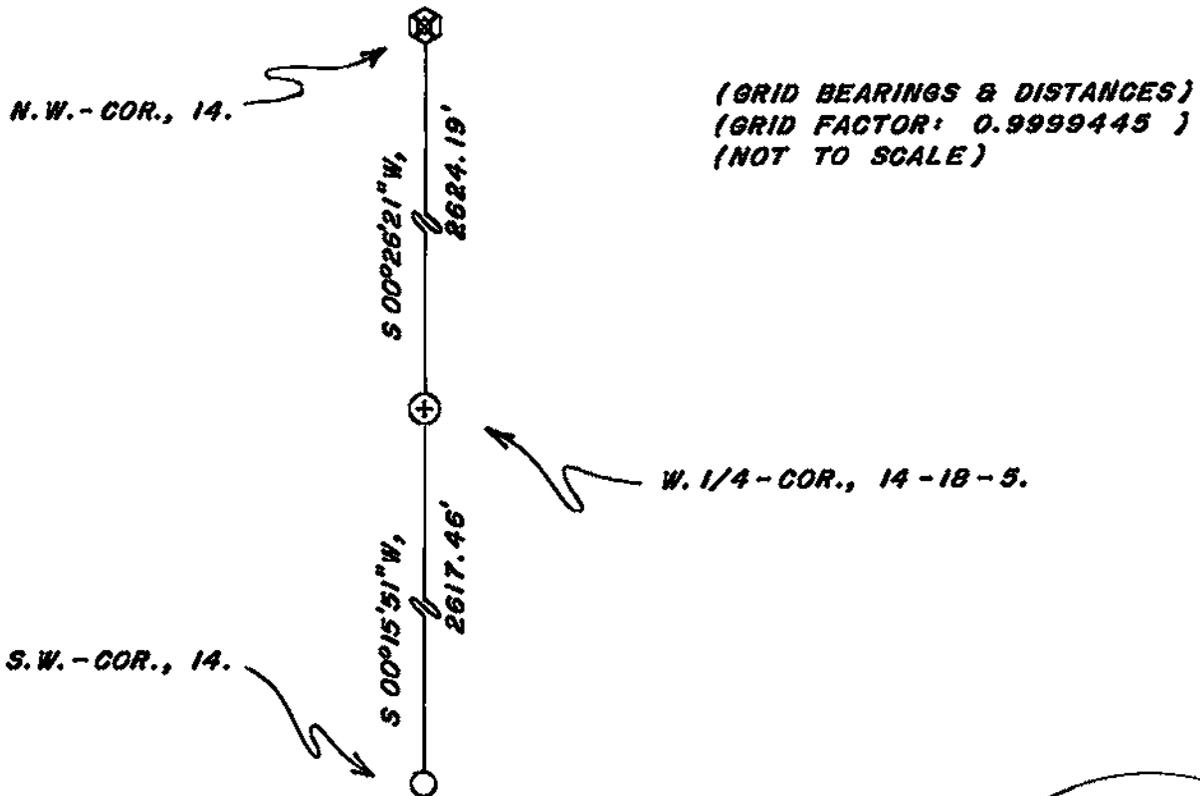

I, WILLIAM C. JUNG, COUNTY SURVEYOR
HEREBY CERTIFY THAT THE CORNER LOCATION SHOWN ON THIS RECORD WAS DETERMINED BY ME OR UNDER MY DIRECTION AND CONTROL AND THAT THIS U. S. PUBLIC LAND SURVEY MONUMENT RECORD IS CORRECT AND COMPLETE TO THE BEST OF MY KNOWLEDGE AND BELIEF.

William C. Jung 11/1/02
Signature Date



Seal