


21805160000

U. S. PUBLIC LAND SURVEY MONUMENT RECORD

SECTION 22 T 18 N, R 5 W, TOWN OF FARMINGTON

LA CROSSE COUNTY

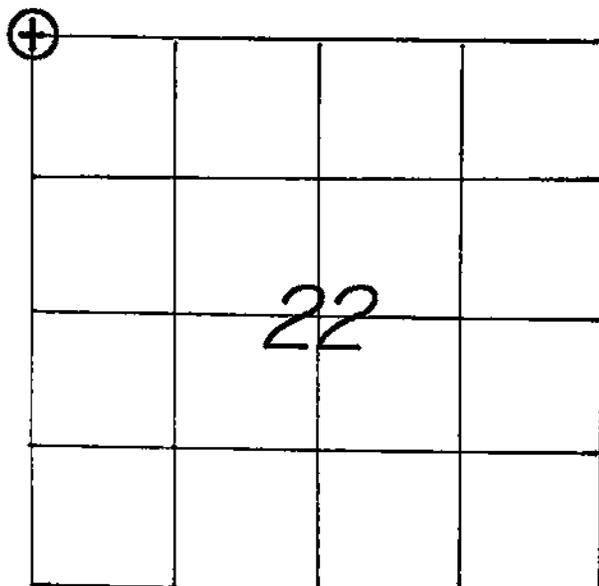

LOCATION OF LANDMARK

CREW: WILLIAM C. JUNG
 PETER F. FOLLANSBEE
 DATE: 10/05/2004

WISCONSIN COORDINATE SYSTEM	
North	740,839.461
East	1,712,633.894
Theta Angle	
Horiz. Order	
Vert. Order	
DATUM:	1983('91)
TYPE OF LANDMARK	
3/4" x 30" IRON BAR WITH AN ALUMINUM CAP.	
BEARINGS ARE REFERENCED TO	
GRID NORTH AS PER SECTION DATA.	

Describe any record evidence, monument evidence, testimonial evidence or any other material evidence you considered and whether the monument was found or restored through acceptance of an obliterated evidence location.


We found a very old East-West fence at this location. Mr. Marvin Young, age 80, a lifelong resident of this area and whose family has been on the nearby farm for well over a 100 years, stated this fence has always been here. I set the corner in the fence and proportionally between the 1/4 corners to the East and West. This fits the East-West shortages that I have encountered. I set a bar and cap at the corner. This also averages for direction with the 1/4 corners and section corners 1/2 mile and 1 mile to the East and West.

Describe or show any material discrepancy between the location of the restored corner and that of the corner previously restored or reestablished.

NONE KNOWN.


RECORD OF DURABLE WITNESS MONUMENTS

NO	DESCRIPTION	MAGNETIC	
		BEARING	DISTANCE
1	SET A NAIL IN N.W.-SIDE OF A 6" ELM	N 75° E	26.12 FT.
2	SET A NAIL IN S.W.-SIDE OF A 17 1/2" OAK	S 89° E	19.93 FT.
3	SET A NAIL IN N.E.-SIDE OF A 3 1/2" ELM	S 34° E	15.60 FT.
4	SET A NAIL IN N.E.-SIDE OF A 14" HICKORY	S 07° W	41.30 FT.

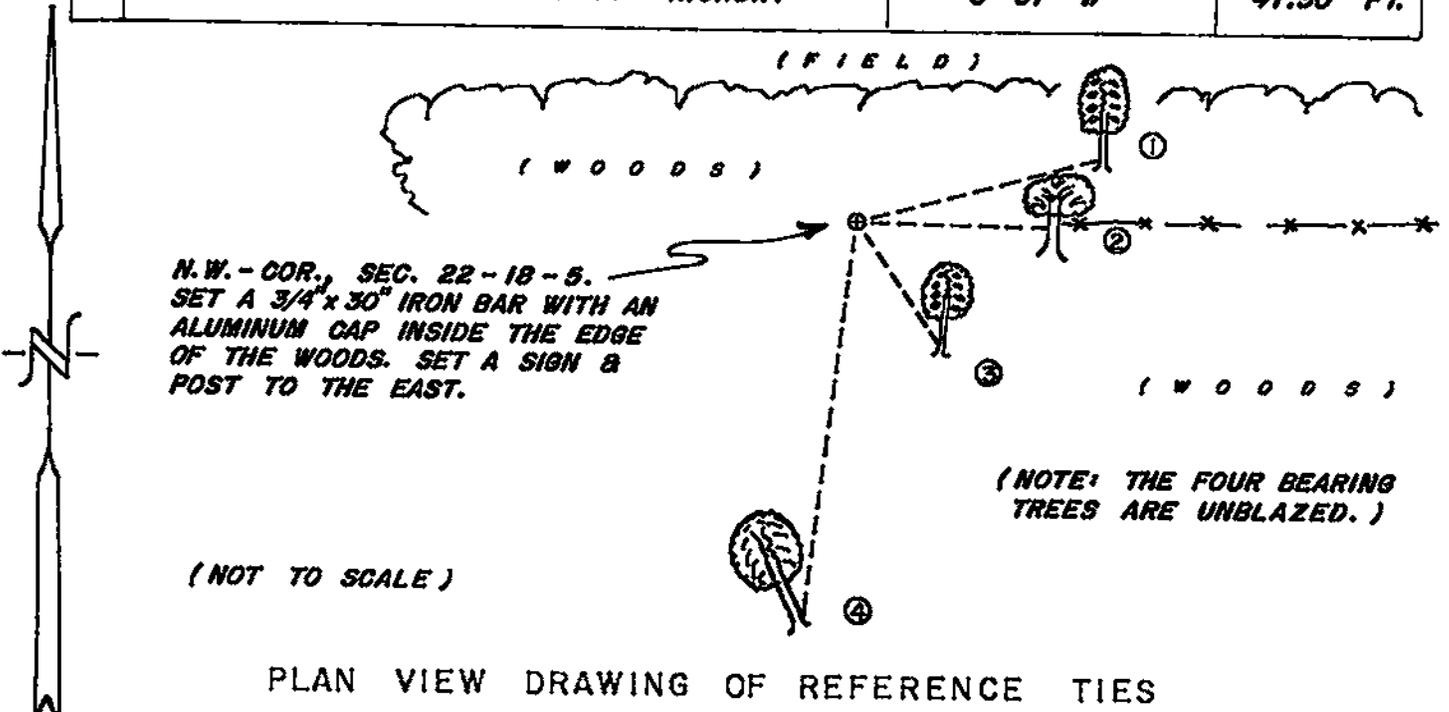

MAP SHOWING DISTANCE AND DIRECTION TO OTHER PUBLIC LAND SURVEY CORNERS USED FOR REESTABLISHING THE CORNER

(GRID BEARINGS AND DISTANCES)
(GRID FACTOR: 0.999943)
(NOT TO SCALE)

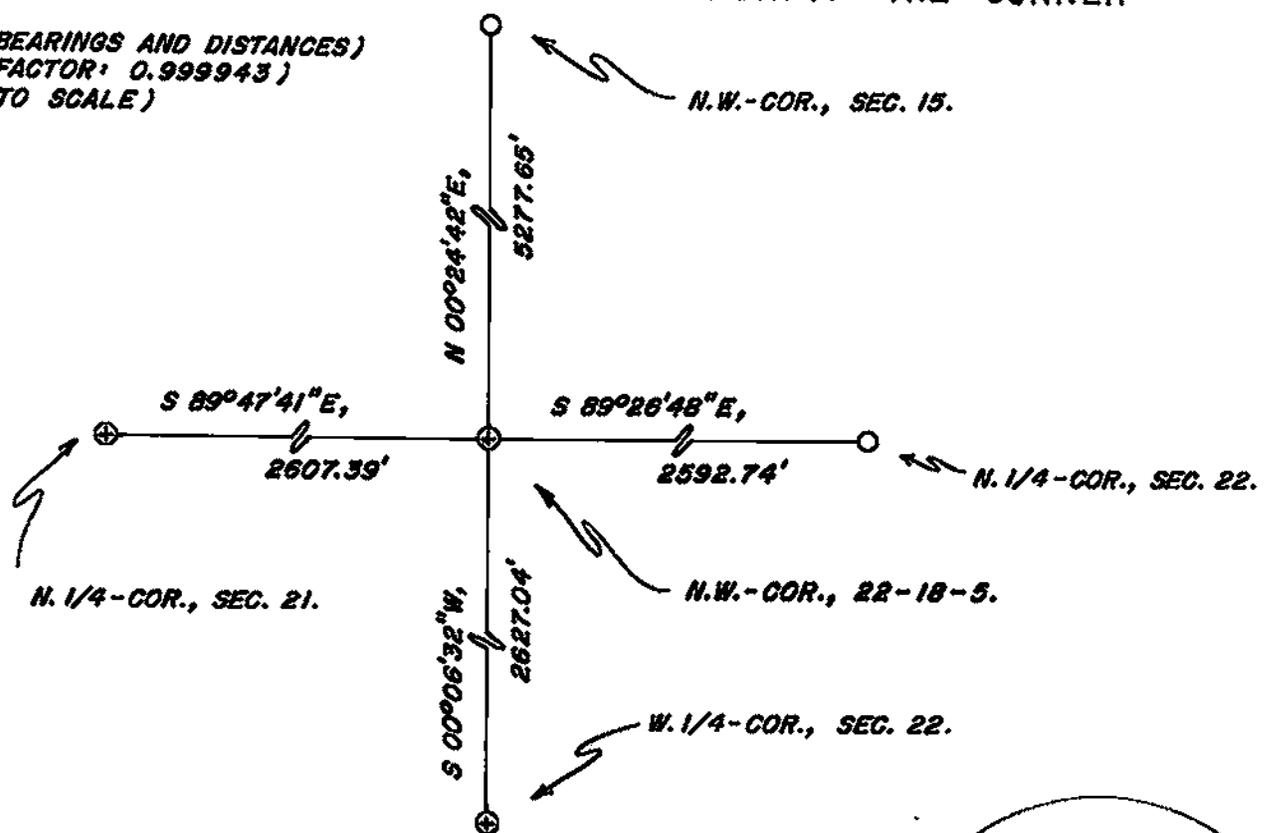

I, WILLIAM C. JUNG, COUNTY SURVEYOR
HEREBY CERTIFY THAT THE CORNER LOCATION SHOWN ON THIS RECORD WAS DETERMINED BY ME OR UNDER MY DIRECTION AND CONTROL AND THAT THIS U. S. PUBLIC LAND SURVEY MONUMENT RECORD IS CORRECT AND COMPLETE TO THE BEST OF MY KNOWLEDGE AND BELIEF.

William C. Jung 10/18/04
Signature Date



Seal