


21805162000

U. S. PUBLIC LAND SURVEY MONUMENT RECORD

SECTION 15 T 18 N, R 5 W, TOWN OF FARMINGTON

LA CROSSE COUNTY

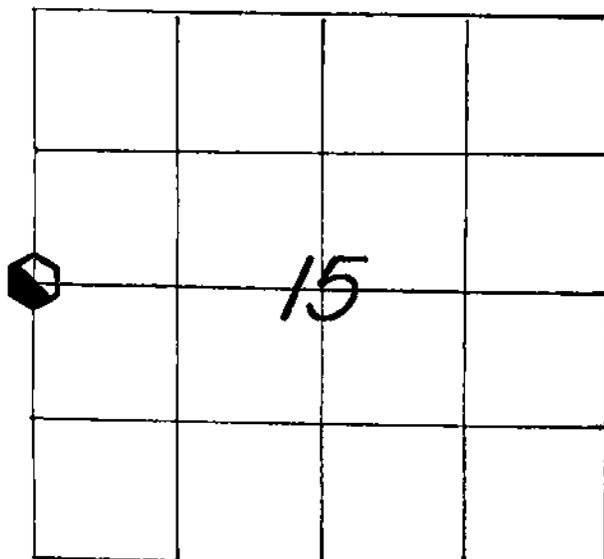

WISCONSIN COORDINATE SYSTEM

North 743,474.857

East 1,712,652.829

Theta Angle

Horiz. Order

Vert. Order

DATUM: 1983('91)

TYPE OF LANDMARK

30" ALUMINUM BERNTSEN MARKER.

BEARINGS ARE REFERENCED TO
GRID NORTH AS PER SECTION DATA.

LOCATION OF LANDMARK

CREW: WILLIAM G. JUNG
 PETER F. FOLLANSBEE
 DATE: 9/11/2007

Describe any record evidence, monument evidence, testimonial evidence or any other material evidence you considered and whether the monument was found or restored through acceptance of an obliterated evidence location.

I accepted the East-West fence as evidence of the old 1/4 lines and therefore set the corner on line between the section corners and in the old fence.


Describe or show any material discrepancy between the location of the restored corner and that of the corner previously restored or reestablished.

NONE KNOWN.


RECORD OF DURABLE WITNESS MONUMENTS

NO	DESCRIPTION	MAGNETIC BEARING	DISTANCE
1	SET A NAIL IN S.W.-SIDE OF A 4-1/2" HICKORY	N 06° W	SLOPE = 31.97'
2	SET A NAIL IN S.E.-SIDE OF A 3" HICKORY	N 39° E	16.72 FT.
3	SET A NAIL IN S.E.-SIDE OF A 5-1/2" HICKORY	N 79° E	47.26 FT.
4	SET A NAIL IN N.E.-SIDE OF A 24" MAPLE	S 40° E	SLOPE = 44.47'

(NOTE: THE FOUR BEARING TREES ARE DOUBLE BLAZED.)

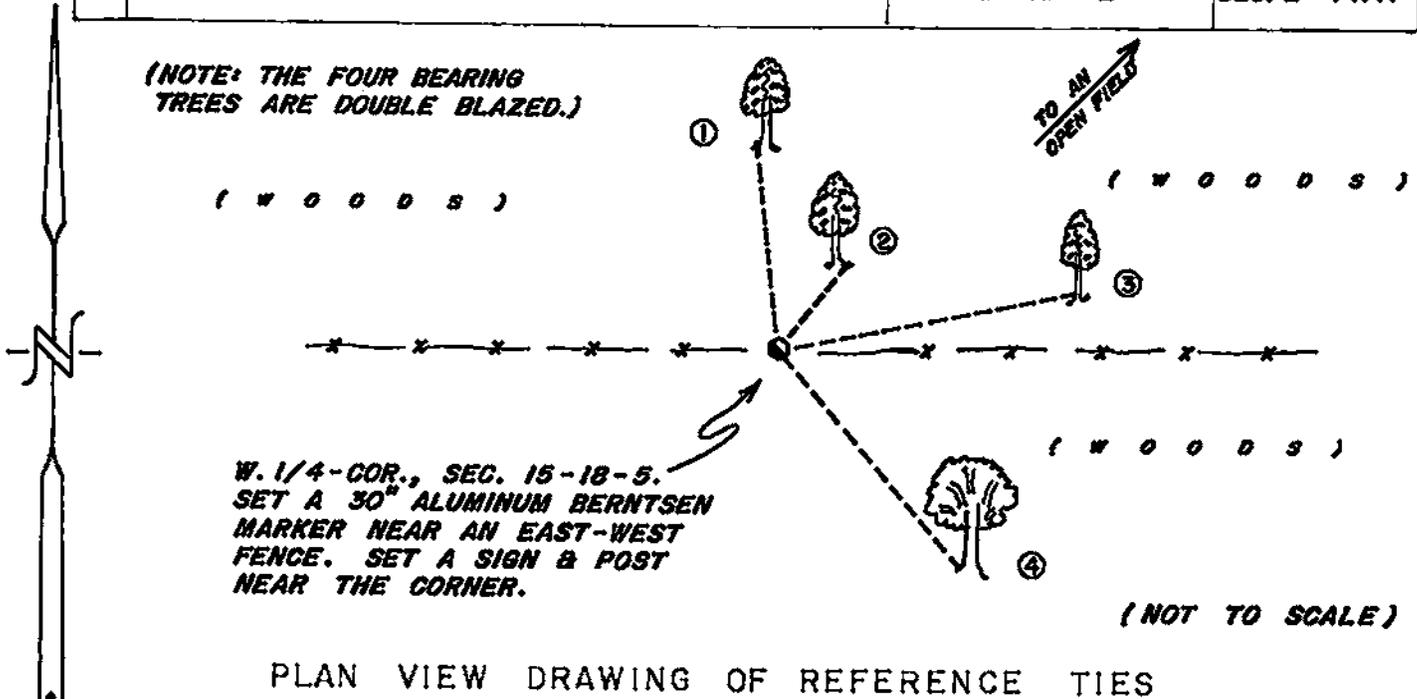

MAP SHOWING DISTANCE AND DIRECTION TO OTHER PUBLIC LAND SURVEY CORNERS USED FOR REESTABLISHING THE CORNER

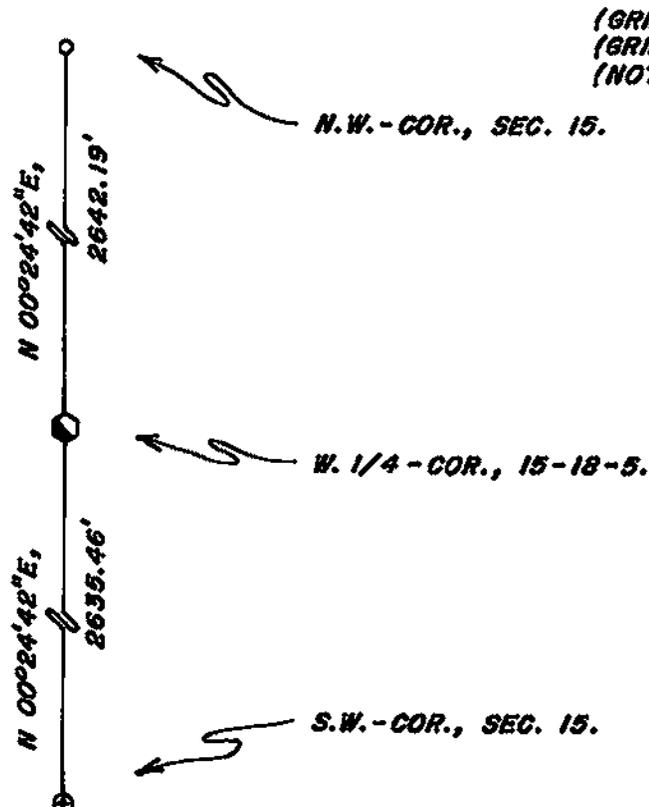

I, WILLIAM C. JUNG, COUNTY SURVEYOR
 HEREBY CERTIFY THAT THE CORNER LOCATION SHOWN ON THIS RECORD WAS DETERMINED BY ME OR UNDER MY DIRECTION AND CONTROL AND THAT THIS U. S. PUBLIC LAND SURVEY MONUMENT RECORD IS CORRECT AND COMPLETE TO THE BEST OF MY KNOWLEDGE AND BELIEF.

William C. Jung
 Signature

10/8/07
 Date



Seal