


21805170000

U. S. PUBLIC LAND SURVEY MONUMENT RECORD

SECTION 20 T 18 N, R 5 W, TOWN OF FARMINGTON
 LA CROSSE COUNTY

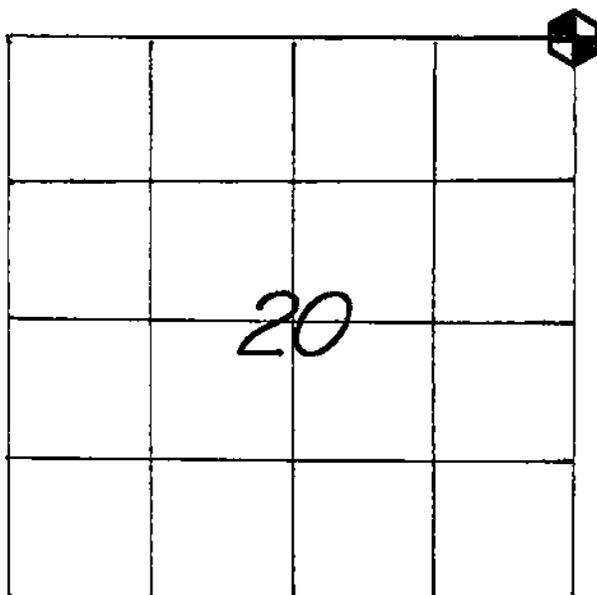

WISCONSIN COORDINATE SYSTEM

North 740870.899

East 1707428.056

Theta Angle

Horiz. Order

Vert. Order

Datum: 1983('91)

TYPE OF LANDMARK

BRASS CAP LUNDE MARKER.

BEARINGS ARE REFERENCED TO

GRID NORTH AS PER SECTION DATA.

LOCATION OF LANDMARK

CREW: **WILLIAM C. JUNG**
PETER F. FOLLANSBEE
 DATE: **5/08/2003**

Describe any record evidence, monument evidence, testimonial evidence or any other material evidence you considered and whether the monument was found or restored through acceptance of an obliterated evidence location.

After surveying out Section 20 and evaluating all the evidence, I accepted the occupied corner as the best available evidence of the original government corner position and monumented it with a brass capped Lunde marker. Mr. Donald Craig, an old nearby resident, told me that this corner has always been occupied as it now is.

Describe or show any material discrepancy between the location of the restored corner and that of the corner previously restored or reestablished.

NONE KNOWN.

