


21805170020

U. S. PUBLIC LAND SURVEY MONUMENT RECORD

SECTION 20 T 18 N, R 5 W, TOWN OF FARMINGTON

LA CROSSE COUNTY

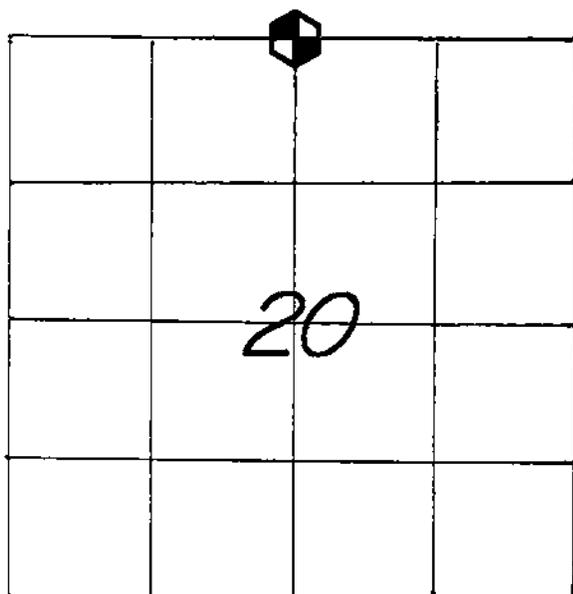

WISCONSIN COORDINATE SYSTEM

North 740898.044

East 1704800.818

Theta Angle

Horiz. Order

Vert. Order

Datum: 1983('91)

TYPE OF LANDMARK

BRASS CAP LUNDE MARKER.

BEARINGS ARE REFERENCED TO

GRID NORTH AS PER SECTION DATA.

LOCATION OF LANDMARK

CREW: **WILLIAM C. JUNG**
PETER F. FOLLANSBEE
 DATE: **5/12/2003**

Describe any record evidence, monument evidence, testimonial evidence or any other material evidence you considered and whether the monument was found or restored through acceptance of an obliterated evidence location.

To the northwest we found an old "knarly" white oak, circumference = 93 inches. In my opinion this tree is an original bearing tree. Therefore, I set the corner from the tree using the original calls. I set a brass capped Lunde marker at the corner. The Lunde is set flush with a sign and post also set nearby. A wine bottle with a shell casing was buried with the marker.


Describe or show any material discrepancy between the location of the restored corner and that of the corner previously restored or reestablished.

NONE KNOWN.

RECORD OF DURABLE WITNESS MONUMENTS


MAGNETIC

NO	DESCRIPTION	BEARING	DISTANCE
1	SET A NAIL IN S.E.-SIDE OF A 29-1/2" WHITE OAK	N9 1/2° W	SLOPE = 29.37'
2	SET A NAIL IN N.-SIDE OF A 15" WHITE OAK	N 78° E	31.02 FT.
3	SET A NAIL IN N.E.-SIDE OF A 4" WHITE OAK	S 79° E	33.19 FT.
4	SET A NAIL IN S.W.-SIDE OF A 6" ELM	S 60° E	19.14 FT.

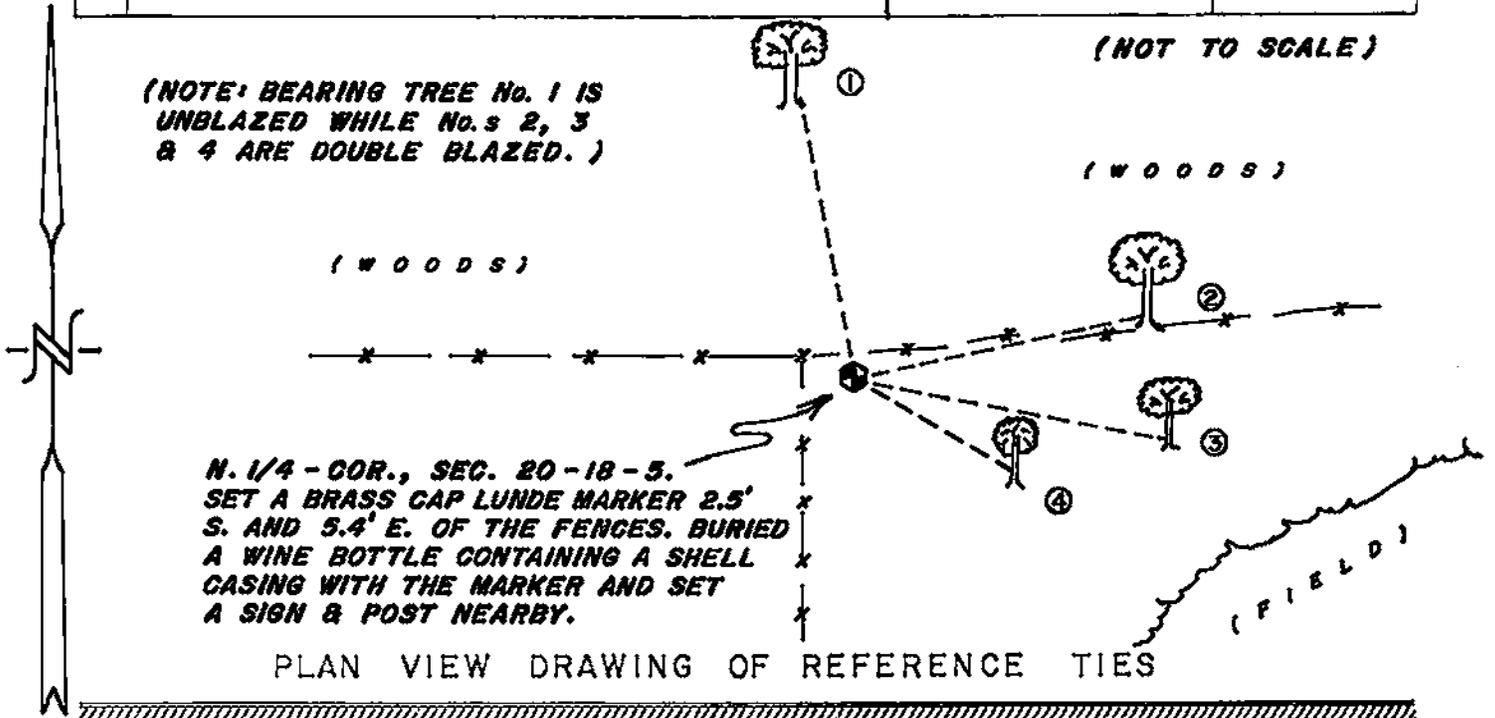

MAP SHOWING DISTANCE AND DIRECTION TO OTHER PUBLIC LAND SURVEY CORNERS USED FOR REESTABLISHING THE CORNER

(GRID BEARINGS & DISTANCES)
 (GRID FACTOR: 0.99995086)
 (NOT TO SCALE)

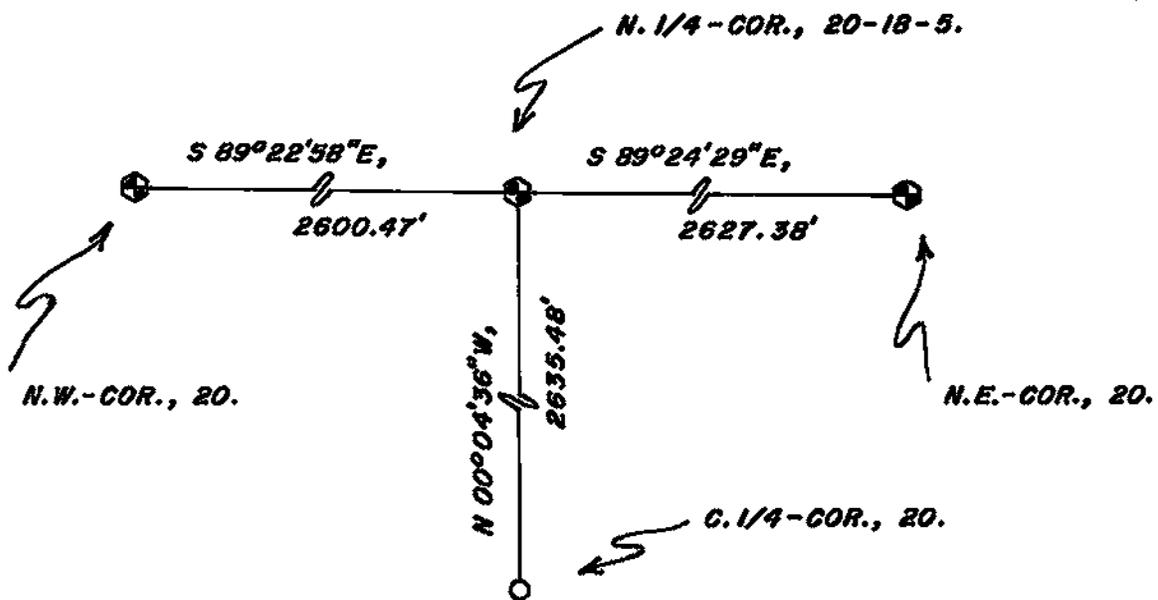

I, WILLIAM C. JUNG, COUNTY SURVEYOR
 HEREBY CERTIFY THAT THE CORNER LOCATION SHOWN ON THIS RECORD WAS DETERMINED BY ME OR UNDER MY DIRECTION AND CONTROL AND THAT THIS U. S. PUBLIC LAND SURVEY MONUMENT RECORD IS CORRECT AND COMPLETE TO THE BEST OF MY KNOWLEDGE AND BELIEF.

William C. Jung
 Signature

6/25/03
 Date



Seal