


21805172000

U. S. PUBLIC LAND SURVEY MONUMENT RECORD

SECTION 17 T 18 N, R 5 W, TOWN OF FARMINGTON

LA CROSSE COUNTY

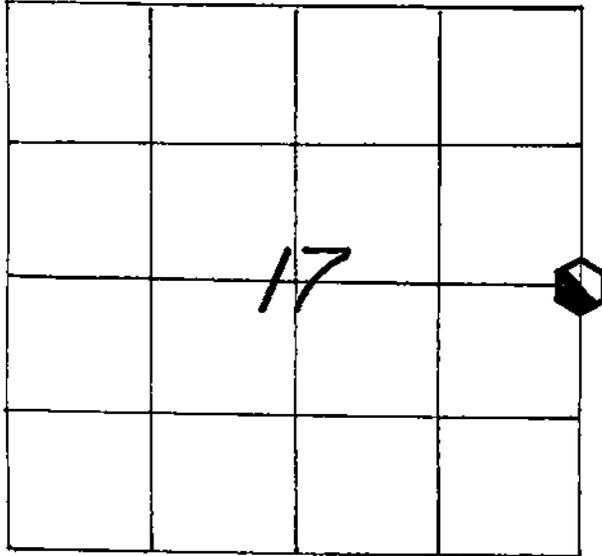

LOCATION OF LANDMARK

CREW: WILLIAM C. JUNG
 PETER F. FOLLANSBEE
 DATE: 6/29/2007

WISCONSIN COORDINATE SYSTEM

North 743,490.954

East 1,707,434.889

Theta Angle

Horiz. Order

Vert. Order

DATUM: 1983 ('91)

TYPE OF LANDMARK

30" ALUMINUM BERNTSEN MARKER.

BEARINGS ARE REFERENCED TO
 GRID NORTH AS PER SECTION DATA.

Describe any record evidence, monument evidence, testimonial evidence or any other material evidence you considered and whether the monument was found or restored through acceptance of an obliterated evidence location.


I accepted the old occupied fence corner location as the best available evidence of the original government corner position and monumented it with a Berntsen marker. The marker is on the south side of an old rotted fence post and West of a newer fence post. Between the marker and the old post is a field stone. It might be there simply as a brace stone for the newer post or it may be an old unrecorded stone at the corner.

Describe or show any material discrepancy between the location of the restored corner and that of the corner previously restored or reestablished.


NONE KNOWN.

RECORD OF DURABLE WITNESS MONUMENTS

NO	DESCRIPTION	BEARING	DISTANCE
1	SET A 3/4" x 30" IRON BAR WITH A RED PLASTIC CAP	N 88°36'20"W (GRID)	755.11' (GRID)
2	SET A 3/4" x 30" IRON BAR WITH A RED PLASTIC CAP	N 66° W (MAG.)	34.07 FT.
3	SET A 3/4" x 30" IRON BAR WITH A RED PLASTIC CAP	N 32° W (MAG.)	22.23 FT.
4	SET A 3/4 x 30" IRON BAR	N 33° E (MAG.)	19.25 FT.

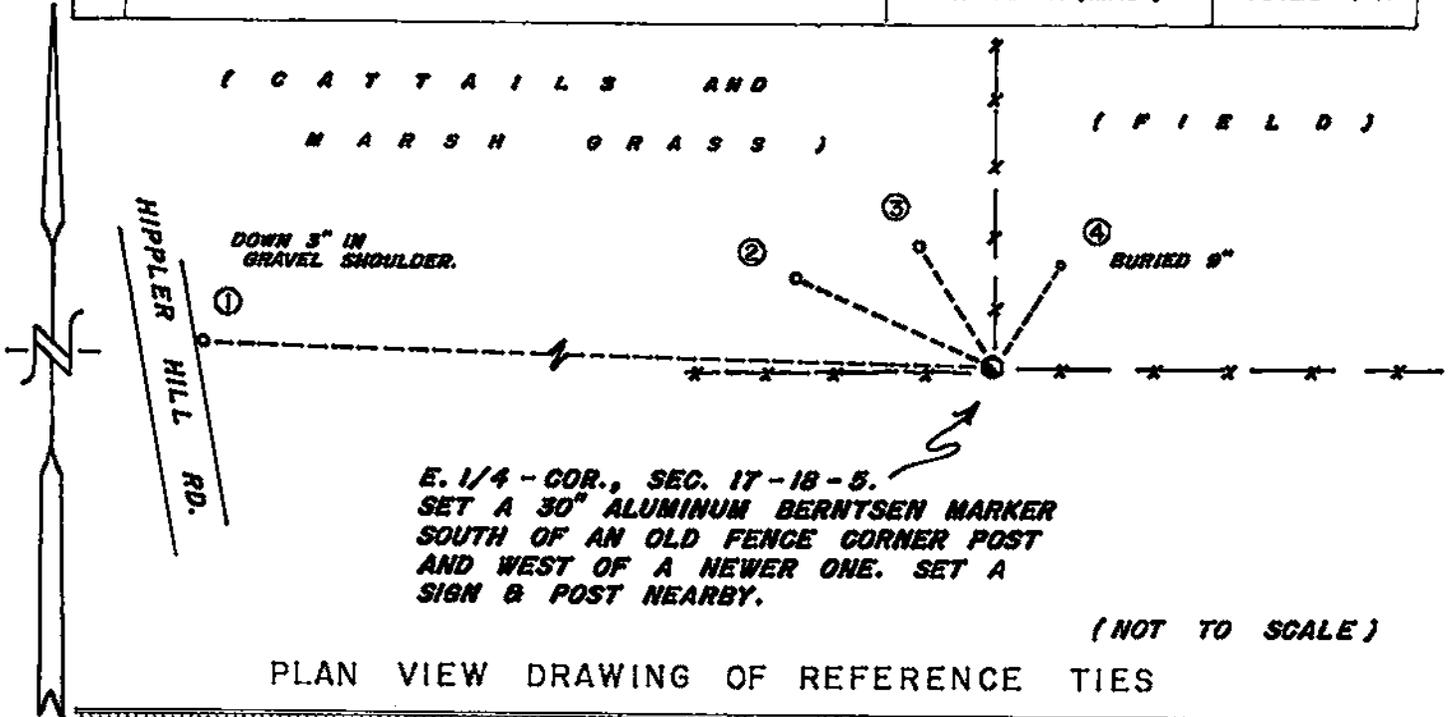

MAP SHOWING DISTANCE AND DIRECTION TO OTHER PUBLIC LAND SURVEY CORNERS USED FOR REESTABLISHING THE CORNER (GRID BEARINGS AND DISTANCES) (GRID FACTOR: 0.999931) (NOT TO SCALE)

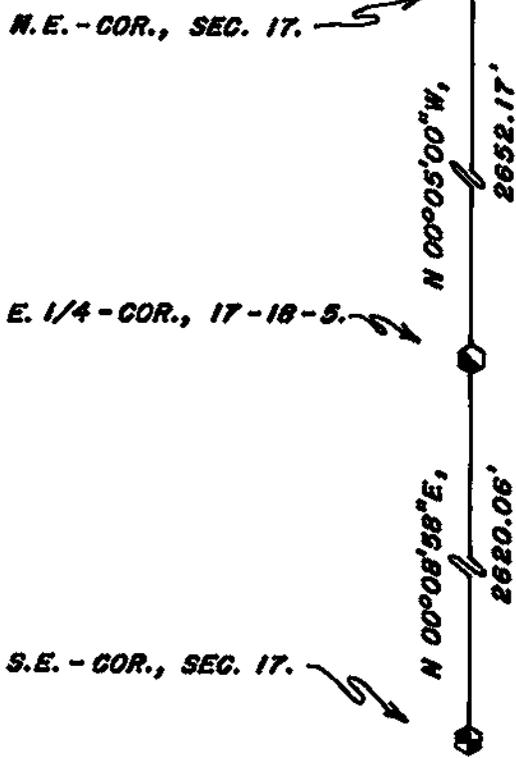

I, WILLIAM C. JUNG, COUNTY SURVEYOR
HEREBY CERTIFY THAT THE CORNER LOCATION SHOWN ON THIS RECORD WAS DETERMINED BY ME OR UNDER MY DIRECTION AND CONTROL AND THAT THIS U. S. PUBLIC LAND SURVEY MONUMENT RECORD IS CORRECT AND COMPLETE TO THE BEST OF MY KNOWLEDGE AND BELIEF.

William C. Jung 8/7/07
Signature Date



Seal