


21805180000

U. S. PUBLIC LAND SURVEY MONUMENT RECORD

SECTION 20 T 18 N, R 5 W, TOWN OF FARMINGTON
LA CROSSE COUNTY

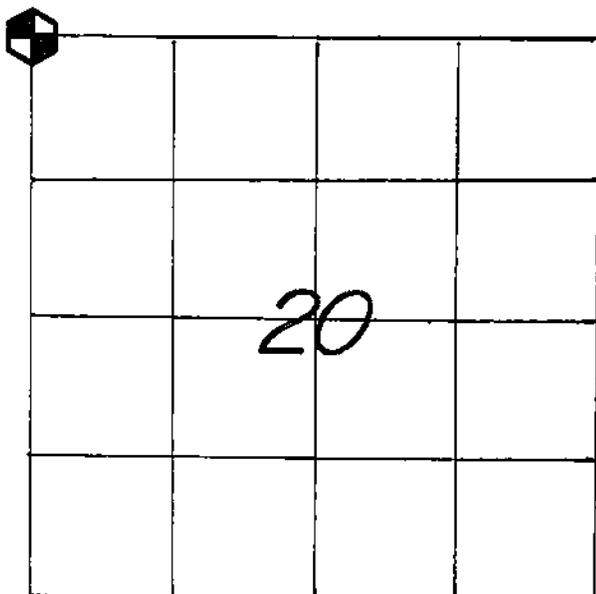

LOCATION OF LANDMARK

CREW: **WILLIAM C. JUNG**
PETER F. FOLLANSBEE
DATE: **5/06/2003**

WISCONSIN COORDINATE SYSTEM

North 740926.061

East 1702200.502

Theta Angle

Horiz. Order

Vert. Order

Datum: 1983('91)

TYPE OF LANDMARK

BRASS CAP LUNDE MARKER.

BEARINGS ARE REFERENCED TO
GRID NORTH AS PER SECTION DATA.

Describe any record evidence, monument evidence, testimonial evidence or any other material evidence you considered and whether the monument was found or restored through acceptance of an obliterated evidence location.

After surveying out Section 20 and evaluating all the evidence, I accepted the occupied corner as the best available evidence of the original government corner position and monumented it with a brass capped Lunde marker. Also, while digging, I dug up a wood post remnant.

Describe or show any material discrepancy between the location of the restored corner and that of the corner previously restored or reestablished.


NONE KNOWN.

RECORD OF DURABLE WITNESS MONUMENTS

NO	DESCRIPTION	MAGNETIC	
		BEARING	DISTANCE
1	SET A NAIL IN S.E.-SIDE OF A 23" WHITE OAK	N 10° E	26.91 FT.
2	SET A NAIL IN S.E.-SIDE OF A 16" OAK	N 29° E	36.06 FT.
3	SET A NAIL IN N.W.-SIDE OF AN 8" WHITE OAK	N 41° E	47.60 FT.
4	SET A NAIL IN S.W.-SIDE OF A 34" OAK	S 45° E	3.16 FT.


(NOTE: BEARING TREES 1, 2 AND 3 ARE DOUBLE BLAZED WHILE No. 4 IS UNBLAZED.)

N.W.-COR., SEC. 20-18-5.
SET A BRASS CAP LUNDE MARKER FLUSH WITH THE GROUND. BURIED A WINE BOTTLE WITH THE MARKER AND SET A SIGN & POST NEARBY.

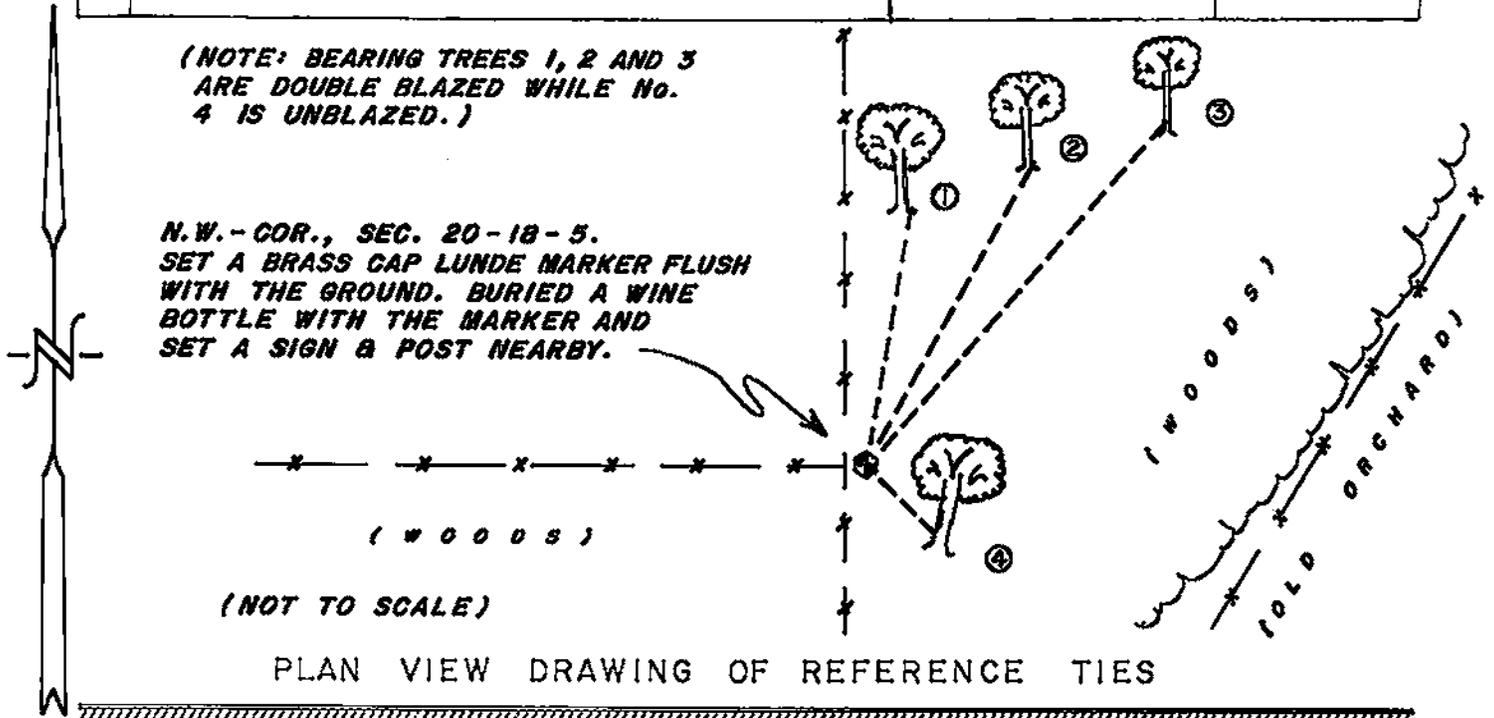

MAP SHOWING DISTANCE AND DIRECTION TO OTHER PUBLIC LAND SURVEY CORNERS USED FOR REESTABLISHING THE CORNER

(GRID BEARINGS & DISTANCES)
(GRID FACTOR: 0.99995086)
(NOT TO SCALE)

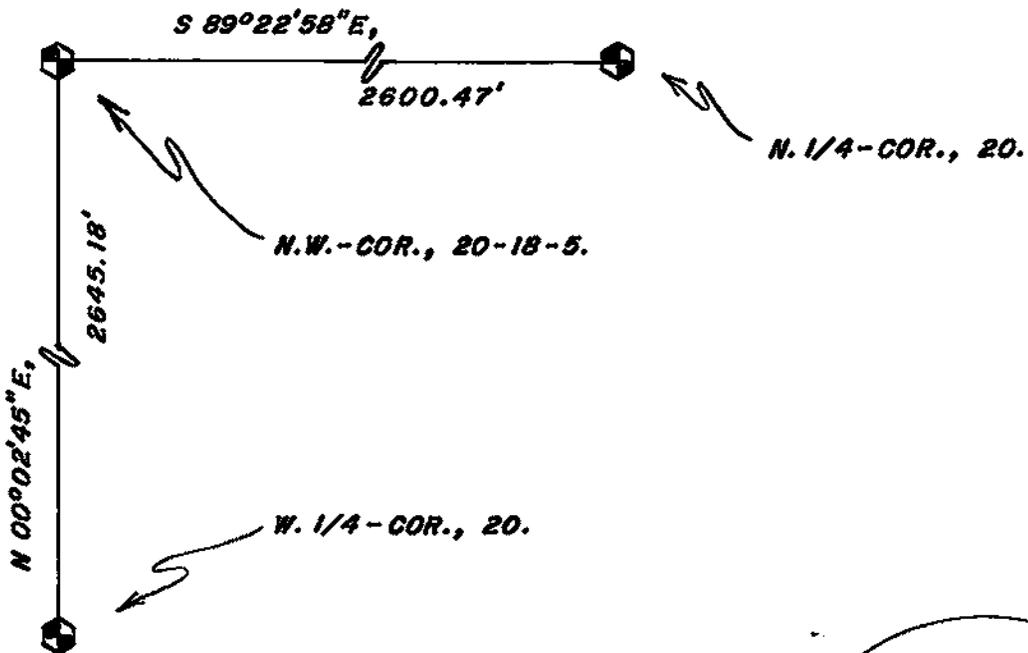

I, WILLIAM C. JUNG, COUNTY SURVEYOR
HEREBY CERTIFY THAT THE CORNER LOCATION SHOWN ON THIS RECORD WAS DETERMINED BY ME OR UNDER MY DIRECTION AND CONTROL AND THAT THIS U. S. PUBLIC LAND SURVEY MONUMENT RECORD IS CORRECT AND COMPLETE TO THE BEST OF MY KNOWLEDGE AND BELIEF.

William C. Jung 6/23/03
Signature Date



Seal