


21805180020

U. S. PUBLIC LAND SURVEY MONUMENT RECORD

SECTION 18 T 18 N, R 5 W, TOWN OF FARMINGTON

LA CROSSE COUNTY

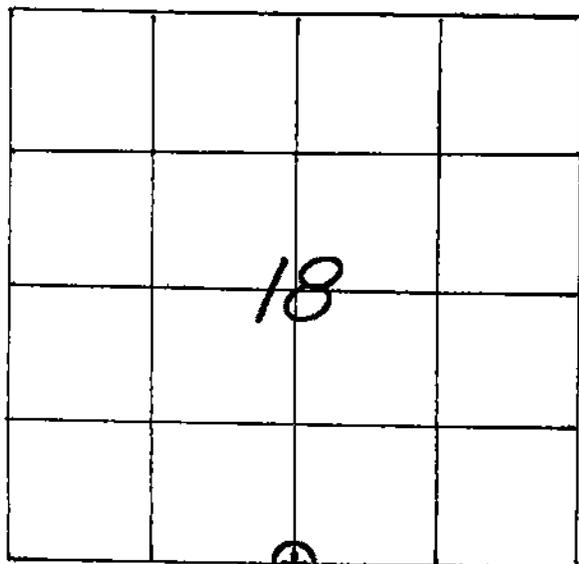

LOCATION OF LANDMARK

CREW: WILLIAM C. JUNG
 PETER F. FOLLANSBEE
 DATE: 9/01/2004

WISCONSIN COORDINATE SYSTEM	
North	740,939.838
East	1,699,591.745
Theta Angle	
Horiz. Order	
Vert. Order	
DATUM:	1983('91)
TYPE OF LANDMARK	
3/4" x 30" IRON BAR WITH AN ALUMINUM CAP.	
BEARINGS ARE REFERENCED TO	
GRID NORTH AS PER SECTION DATA.	

Describe any record evidence, monument evidence, testimonial evidence or any other material evidence you considered and whether the monument was found or restored through acceptance of an obliterated evidence location.


We found an old four way fence corner and accepted it as the best available evidence of the original government corner position. We monumented the corner with a bar and cap and set a sign and post to the Northeast.

Describe or show any material discrepancy between the location of the restored corner and that of the corner previously restored or reestablished.

NONE KNOWN.


RECORD OF DURABLE WITNESS MONUMENTS

NO	DESCRIPTION	MAGNETIC	
		BEARING	DISTANCE
1	SET A NAIL IN S.E.-SIDE OF A 7" BOX ELDER	N 80° W	1.59 FT.
2	SET A NAIL IN N.E.-SIDE OF A 14" HICKORY	N 35° W	17.44 FT.
3	SET A NAIL IN S.W.-SIDE OF A 4" NUT TREE	S 64° E	8.74 FT.
4	SET A NAIL IN S.E.-SIDE OF A 4 1/2" NUT TREE	S 39° W	18.32 FT.

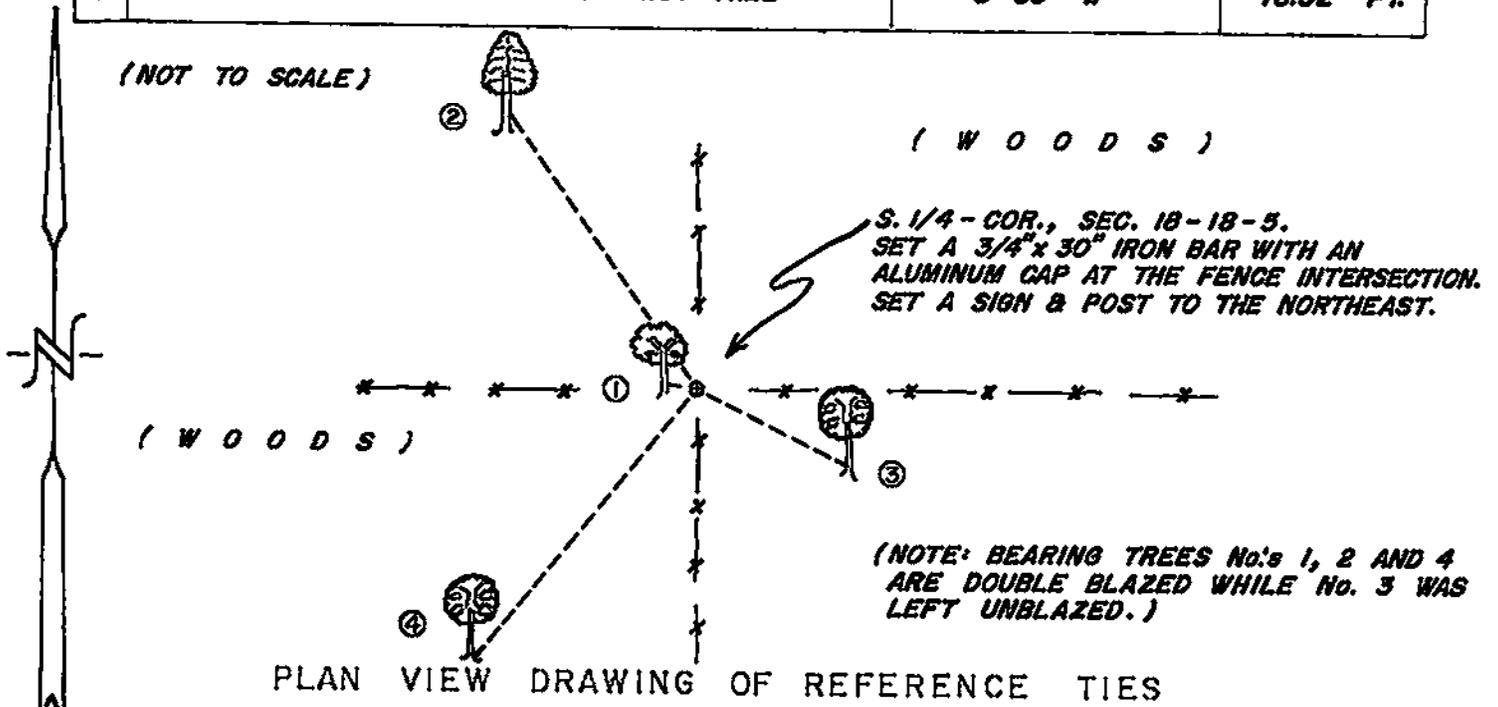


MAP SHOWING DISTANCE AND DIRECTION TO OTHER PUBLIC LAND SURVEY CORNERS USED FOR REESTABLISHING THE CORNER

(GRID BEARINGS AND DISTANCES)
(GRID FACTOR: 0.999956)
(NOT TO SCALE)

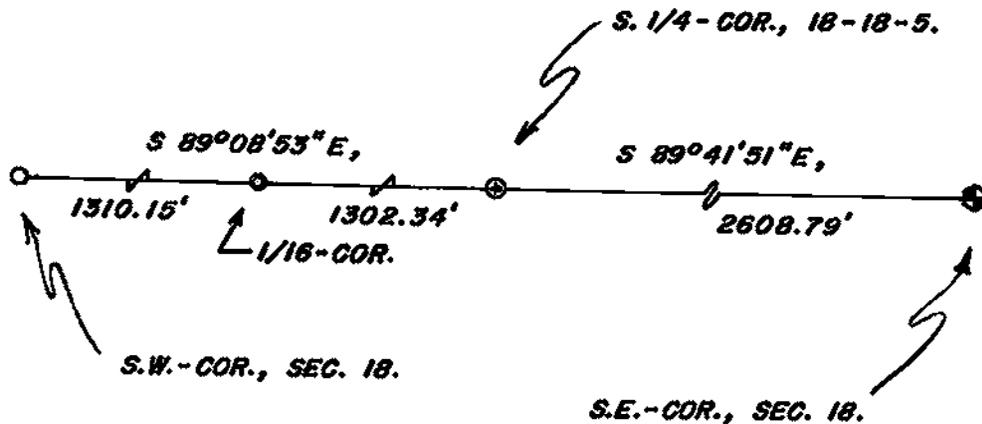

I, WILLIAM C. JUNG, COUNTY SURVEYOR
HEREBY CERTIFY THAT THE CORNER LOCATION SHOWN ON THIS RECORD WAS DETERMINED BY ME OR UNDER MY DIRECTION AND CONTROL AND THAT THIS U. S. PUBLIC LAND SURVEY MONUMENT RECORD IS CORRECT AND COMPLETE TO THE BEST OF MY KNOWLEDGE AND BELIEF.

William C. Jung 12/31/04
Signature Date

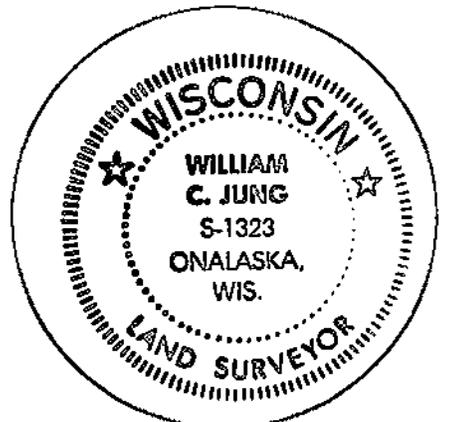

Seal