


21805182000

## U. S. PUBLIC LAND SURVEY MONUMENT RECORD

SECTION 17 T 18 N, R 5 W, TOWN OF FARMINGTON

LA CROSSE COUNTY

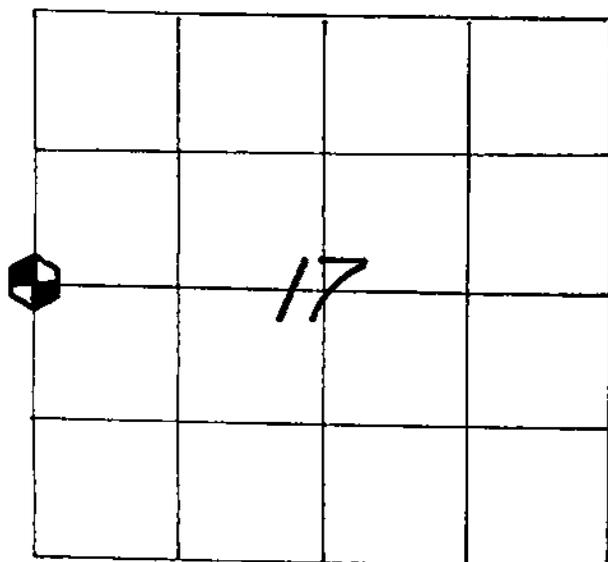

LOCATION OF LANDMARK

CREW: WILLIAM C. JUNG  
 PETER F. FOLLANSBEE  
 DATE: 7/24/2007

## WISCONSIN COORDINATE SYSTEM

North **743,541.583**East **1,702,188.273**

Theta Angle

Horiz. Order

Vert. Order

DATUM: **1983('91)**

TYPE OF LANDMARK

**BRASS CAP LUNDE MARKER.**

BEARINGS ARE REFERENCED TO  
**GRID NORTH AS PER SECTION DATA.**

Describe any record evidence, monument evidence, testimonial evidence or any other material evidence you considered and whether the monument was found or restored through acceptance of an obliterated evidence location.

I set this corner by single proportionate measurement. We found a 43" white oak at N64<sup>o</sup>E, 23.60 feet. The original notes called for a 14" white oak at S64<sup>o</sup>E, 23.7 feet. Could it be that the oak that we found is actually the original tree and that there is an error in the notes? Was it supposed to be N64<sup>o</sup>E instead of S64<sup>o</sup>E? Possibly. I've seen that happen before. If that were the case, the corner is still good.


Describe or show any material discrepancy between the location of the restored corner and that of the corner previously restored or reestablished.

**NONE KNOWN.**

RECORD OF DURABLE WITNESS MONUMENTS


NO	DESCRIPTION	MAGNETIC BEARING	DISTANCE
1	SET A NAIL IN S.E.-SIDE OF AN 18" MAPLE	N 40° E	34.18 FT.
2	SET A NAIL IN N.W.-SIDE OF A 45" WHITE OAK	N 64 1/2° E	23.60 FT.
3	SET A NAIL IN S.W.-SIDE OF A 21" WHITE OAK	S 49° E	25.40 FT.
4	SET A NAIL IN N.E.-SIDE OF A 5 1/2" MAPLE	S 14° E	16.68 FT.

(NOTE: BEARING TREES 1 AND 4 ARE DOUBLE BLAZED WHILE No.s 2 AND 3 WERE LEFT UNBLAZED.)

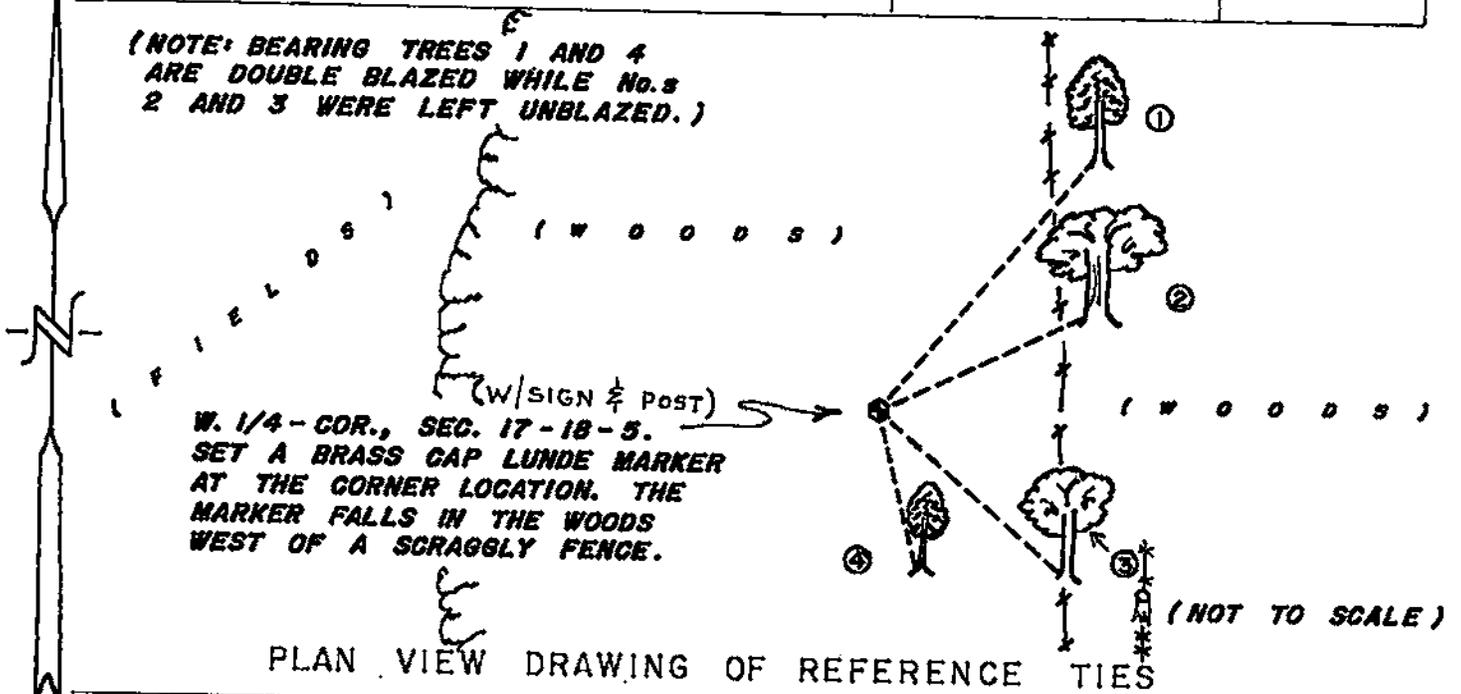


MAP SHOWING DISTANCE AND DIRECTION TO OTHER PUBLIC LAND SURVEY CORNERS USED FOR REESTABLISHING THE CORNER

(GRID BEARINGS AND DISTANCES)  
(GRID FACTOR: 0.999951)  
(NOT TO SCALE)

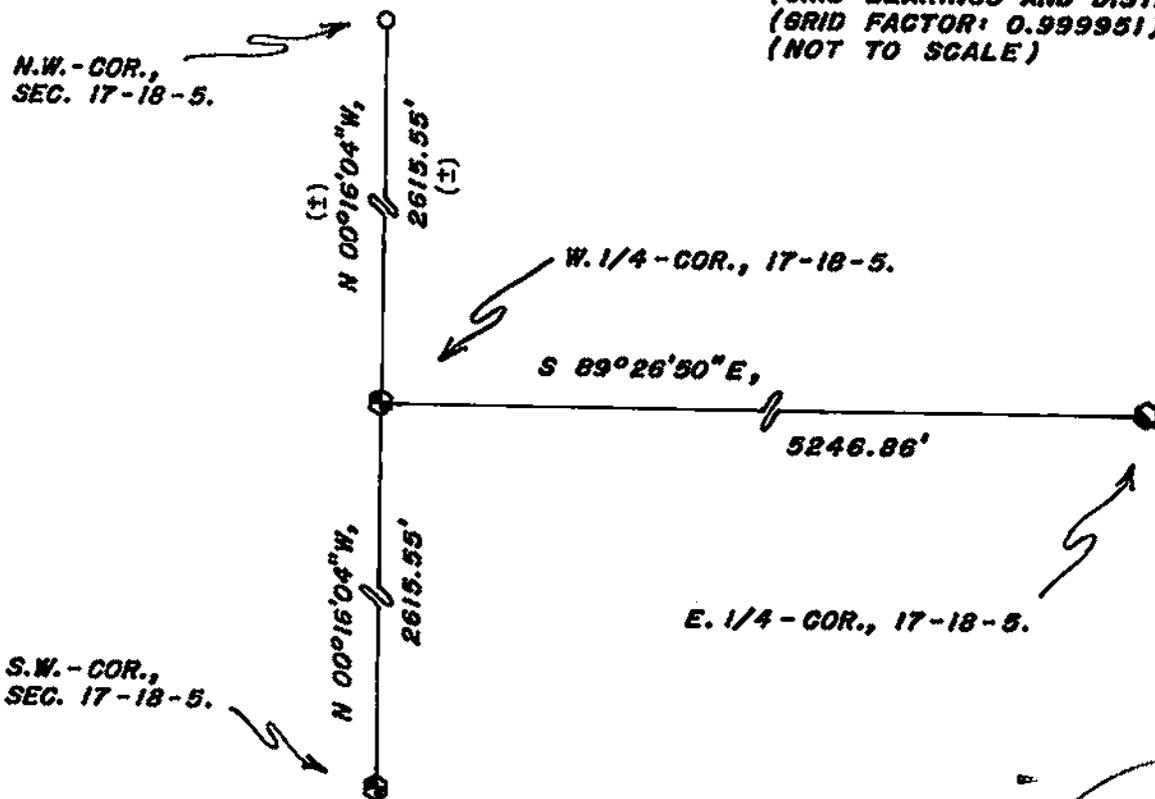

I, WILLIAM C. JUNG, COUNTY SURVEYOR  
HEREBY CERTIFY THAT THE CORNER LOCATION SHOWN ON THIS RECORD WAS DETERMINED BY ME OR UNDER MY DIRECTION AND CONTROL AND THAT THIS U. S. PUBLIC LAND SURVEY MONUMENT RECORD IS CORRECT AND COMPLETE TO THE BEST OF MY KNOWLEDGE AND BELIEF.

William C. Jung                      8/7/07  
Signature                                      Date

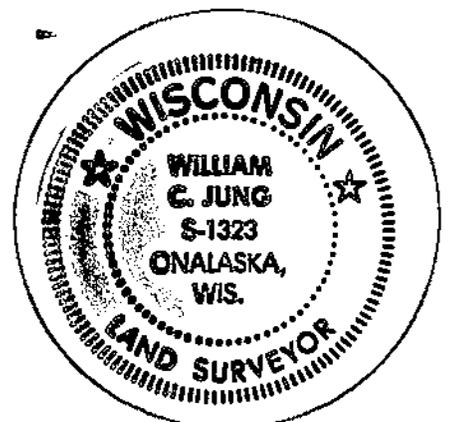

Seal