


21805202000

U. S. PUBLIC LAND SURVEY MONUMENT RECORD

SECTION 20 T 18 N, R 5 W, TOWN OF FARMINGTON
LA CROSSE COUNTY

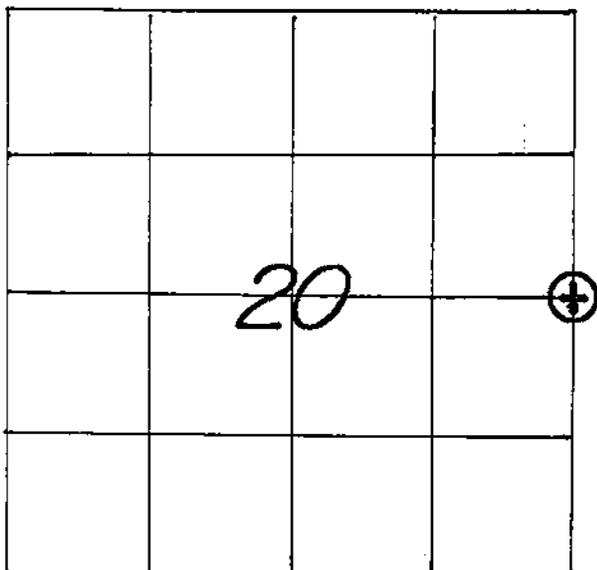

LOCATION OF LANDMARK

CREW: **WILLIAM C. JUNG**
PETER F. FOLLANSBEE
DATE: **5/15/2003**

WISCONSIN COORDINATE SYSTEM	
North	738,236.533
East	1,707,428.621
Theta Angle	
Horiz. Order	
Vert. Order	
DATUM:	1983('91)
TYPE OF LANDMARK	
3/4" x 30" IRON BAR WITH ALUMINUM CAP.	
BEARINGS ARE REFERENCED TO	
GRID NORTH AS PER SECTION DATA.	

Describe any record evidence, monument evidence, testimonial evidence or any other material evidence you considered and whether the monument was found or restored through acceptance of an obliterated evidence location.

To the Southwest we found a very old, huge, and partially dead oak tree. It is growing on the North side of a rock face and has a circumference of 114 inches plus. In my opinion this tree is an original bearing tree. Therefore, I set the corner from the tree using the original calls. I set a bar and cap at the corner. It falls about 19 feet south of the creek centerline. The original call was 5.6 feet. A sign and post were set nearby. N27°W, 5.39 feet, is an iron bar and cap which is only a survey point. Describe or show any material discrepancy between the location of the restored corner and that of the corner previously restored or reestablished.

NONE KNOWN.

