


21805202020

U. S. PUBLIC LAND SURVEY MONUMENT RECORD

SECTION 20 T 18 N, R 5 W, TOWN OF FARMINGTON
 LA CROSSE COUNTY

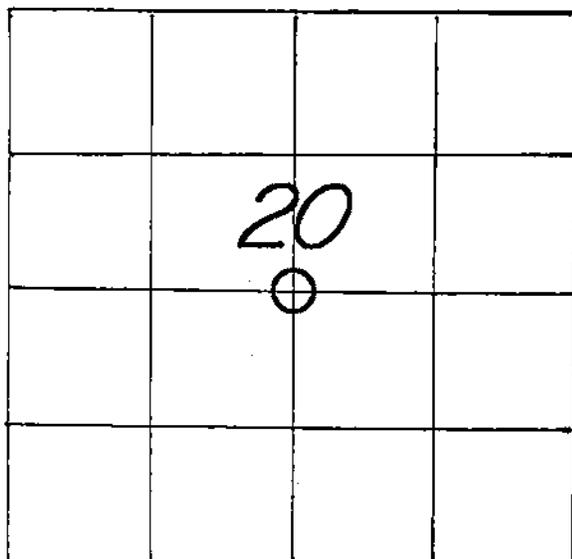

LOCATION OF LANDMARK

CREW: **WILLIAM G. JUNG**
PETER F. FOLLANSBEE
 DATE: **5/01/2003**

WISCONSIN COORDINATE SYSTEM	
North	738262.563
East	1704804.338
Theta Angle	
Horiz. Order	
Vert. Order	
Datum:	1983('91)
TYPE OF LANDMARK	
1-1/8" x 49" IRON PIPE.	
BEARINGS ARE REFERENCED TO	
GRID NORTH AS PER SECTION DATA.	

Describe any record evidence, monument evidence, testimonial evidence or any other material evidence you considered and whether the monument was found or restored through acceptance of an obliterated evidence location.


I found an old corner post at the corner. After surveying out Section 20 and evaluating all the evidence, it is my opinion that the old corner post marks a location where a surveyor years ago in an unrecorded survey (it may have been recorded but those records are lost) attempted to set the corner "by law" at the intersection of the 1/4 lines. The old post is about 3.8 feet North and about 2.8 feet West of the true center 1/4 corner. This would have been within the standard when *** Describe or show any material discrepancy between the location of the restored corner and that of the corner previously restored or reestablished.

NONE KNOWN.


*** this section was first "split". As such, I accepted the old post location as the best available evidence of the old corner and monumented it with an iron pipe.

RECORD OF DURABLE WITNESS MONUMENTS
MAGNETIC

NO	DESCRIPTION	BEARING	DISTANCE
1	SET A NAIL IN N.-SIDE OF A 21" MAPLE	N 86° W	27.29 FT.
2	SET A 3/4" x 30" IRON BAR WITH RED PLASTIC CAP	NORTH ±	27.96 FT.
3	SET A 3/4" x 30" IRON BAR WITH RED PLASTIC CAP	SOUTHERLY ±	25.54 FT.
4	SET A NAIL IN E.-SIDE OF A 10" BOX ELDER	S 05° W	31.25 FT.

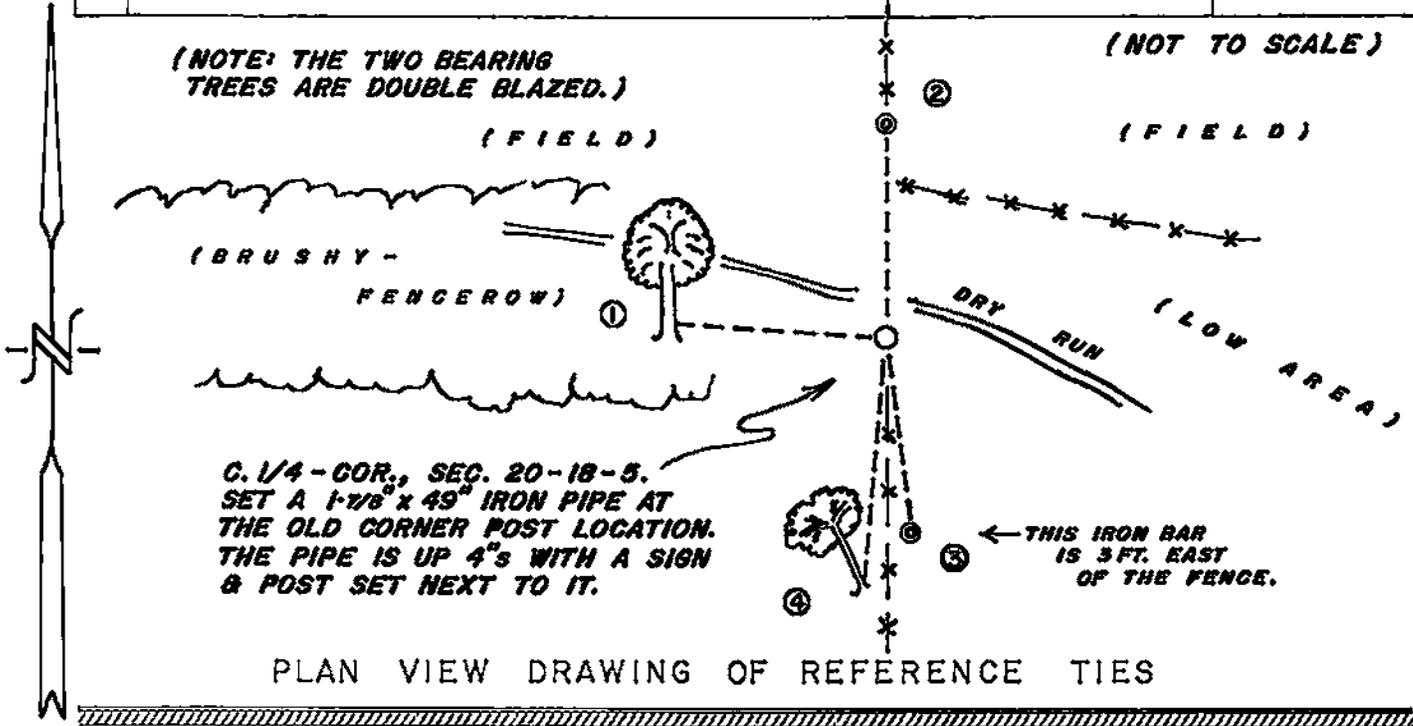


MAP SHOWING DISTANCE AND DIRECTION TO OTHER PUBLIC LAND SURVEY CORNERS USED FOR REESTABLISHING THE CORNER

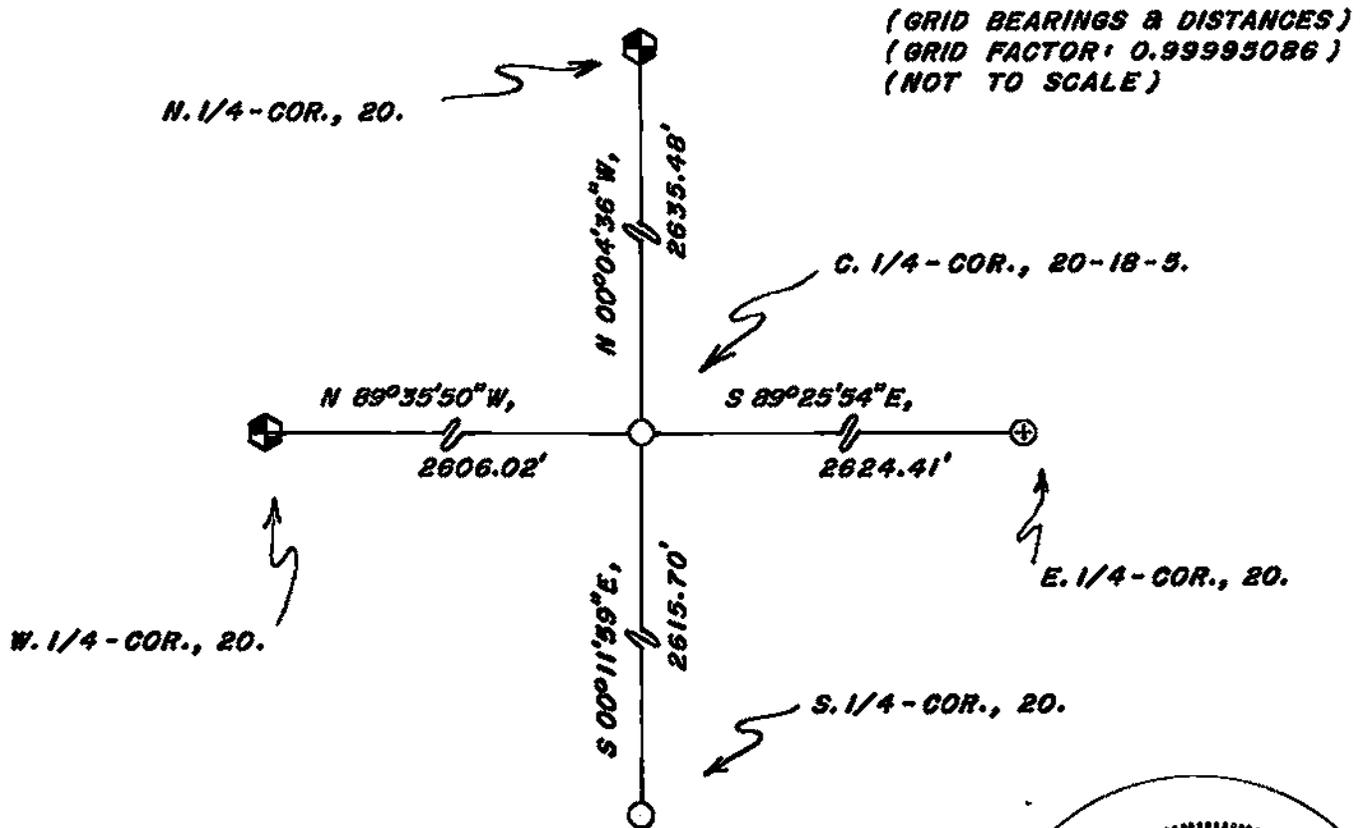

I, WILLIAM G. JUNG, COUNTY SURVEYOR
HEREBY CERTIFY THAT THE CORNER LOCATION SHOWN ON THIS RECORD WAS DETERMINED BY ME OR UNDER MY DIRECTION AND CONTROL AND THAT THIS U. S. PUBLIC LAND SURVEY MONUMENT RECORD IS CORRECT AND COMPLETE TO THE BEST OF MY KNOWLEDGE AND BELIEF.

William C. Jung 6/25/03
Signature Date

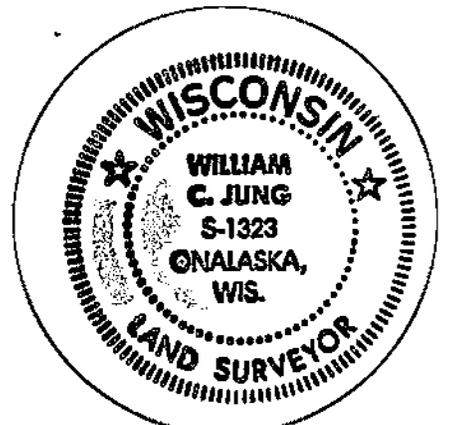

Seal