


U. S. PUBLIC LAND SURVEY MONUMENT RECORD

SECTION 28 T 18 N, R 5 W, TOWN OF FARMINGTON

LA CROSSE COUNTY

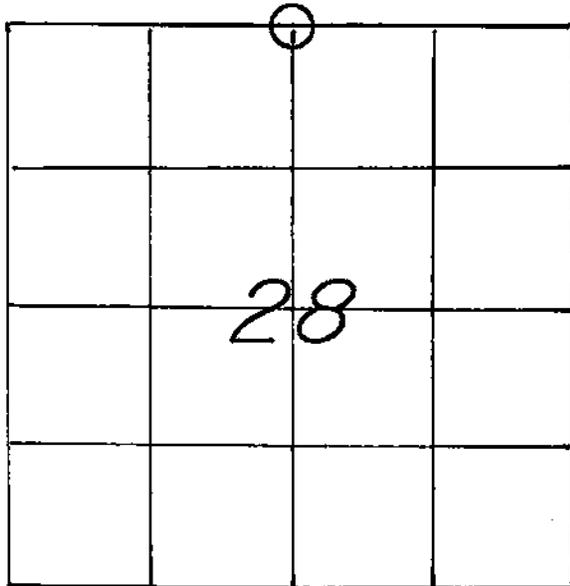

LOCATION OF LANDMARK

WISCONSIN COORDINATE SYSTEM

North

East

Theta Angle

Horiz. Order

Vert. Order

TYPE OF LANDMARK

1" Iron Pipe.

BEARINGS ARE REFERENCED TO

Assumed North.

Crew: WILLIAM C. JUNG  
 PETER F. FOLLANSBEE  
 Date: 2/05/1997

Describe any record evidence, monument evidence, testimonial evidence or any other material evidence you considered and whether the monument was found or restored through acceptance of an obliterated evidence location.


I've accepted the old occupied corner as the best available evidence of the original government corner position and monumented it with an Iron Pipe.

Describe or show any material discrepancy between the location of the restored corner and that of the corner previously restored or reestablished.


None Known.

RECORD OF DURABLE WITNESS MONUMENTS

NO	DESCRIPTION	MAGNETIC BEARING	DISTANCE
1	Set P.K. Nail in SW-side 3½" Hickory	N 74°W	23.54 Ft.
2	Set P.K. Nail in E.-side 9½" Oak	N 01°E	6.58 Ft.
3	Set P.K. Nail in SE-side 12" Cherry	N 47°E	30.00 Ft.
4	Set P.K. Nail in NE-side 7" Cherry	S 65°E	36.69 Ft.

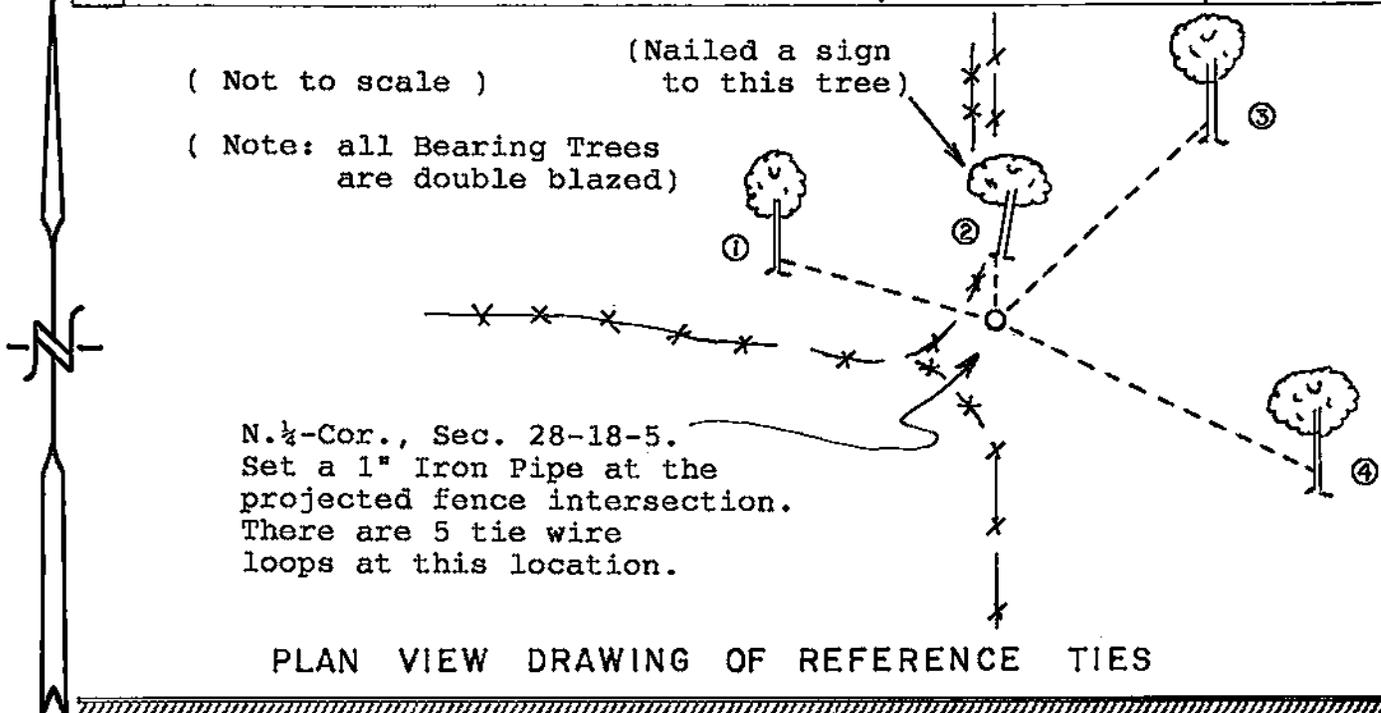


MAP SHOWING DISTANCE AND DIRECTION TO OTHER PUBLIC LAND SURVEY CORNERS USED FOR REESTABLISHING THE CORNER

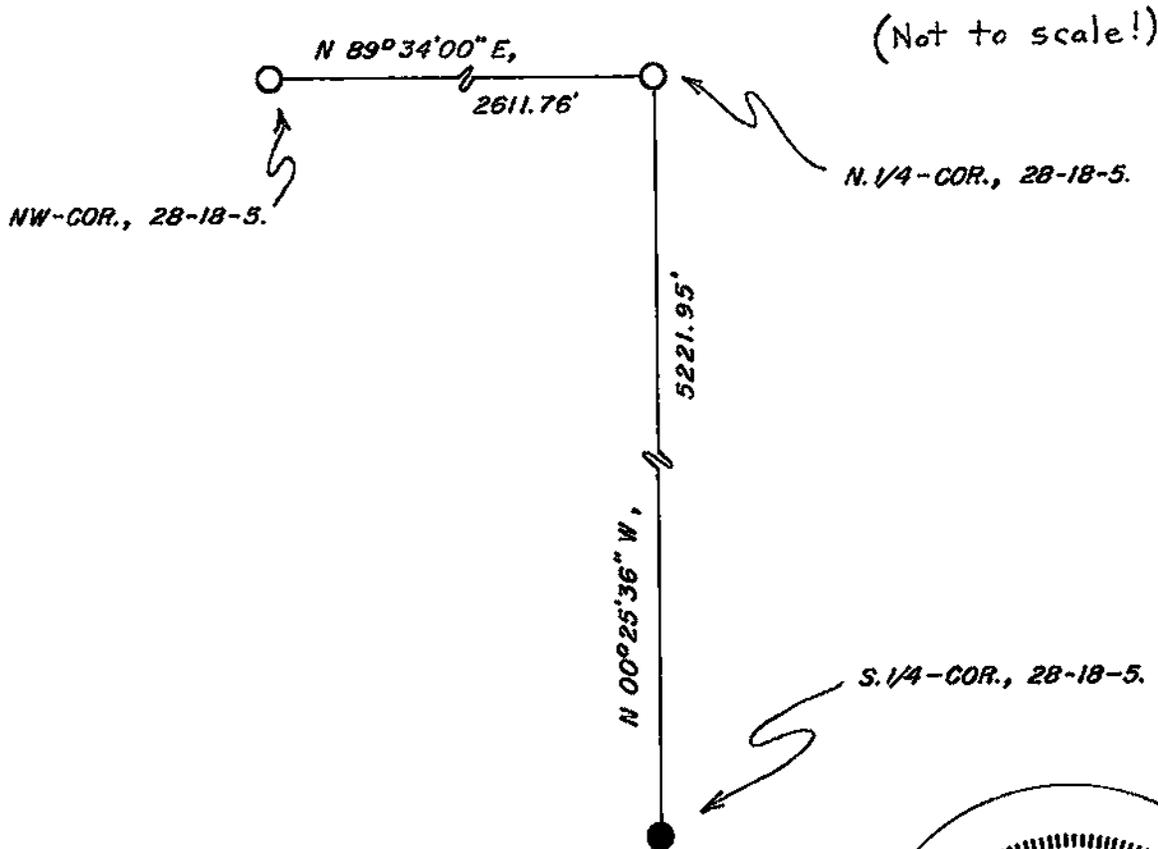

I, William C. Jung, County Surveyor  
 HEREBY CERTIFY THAT THE CORNER LOCATION SHOWN ON THIS RECORD  
 WAS DETERMINED BY ME OR UNDER MY DIRECTION AND CONTROL AND  
 THAT THIS U. S. PUBLIC LAND SURVEY MONUMENT RECORD IS CORRECT  
 AND COMPLETE TO THE BEST OF MY KNOWLEDGE AND BELIEF.

William C. Jung                      6/12/97  
 Signature                                      Date

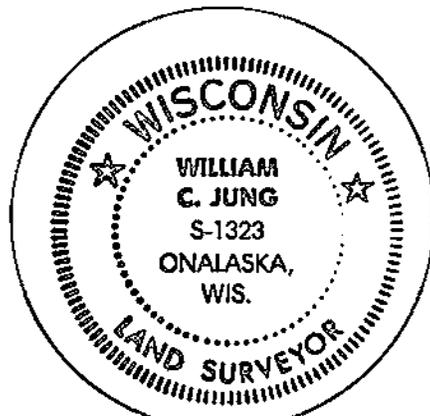

Seal