


U. S. PUBLIC LAND SURVEY MONUMENT RECORD

SECTION 27 T 18 N, R 5 W, TOWN OF Farmington

LA CROSSE COUNTY

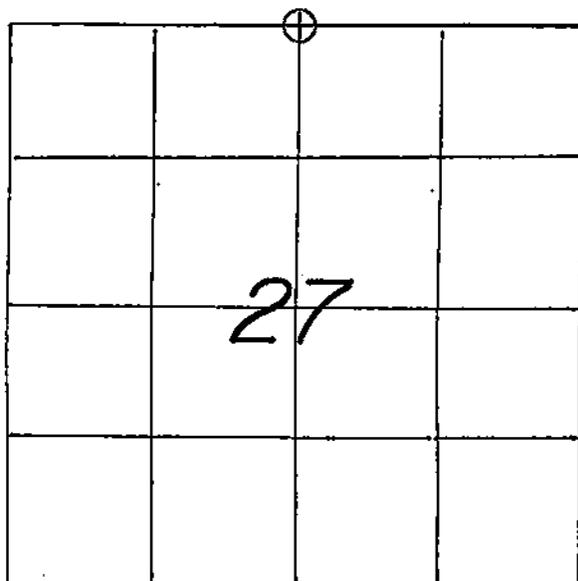

LOCATION OF LANDMARK

WISCONSIN COORDINATE SYSTEM
North
East
Theta Angle
Horiz. Order
Vert. Order
TYPE OF LANDMARK
3/4"x30" iron bar w/cap
BEARINGS ARE REFERENCED TO

Crew: William C. Jung
 Peter F. Follansbee
 Date: 2/3/99

Describe any record evidence, monument evidence, testimonial evidence or any other material evidence you considered and whether the monument was found or restored through acceptance of an obliterated evidence location.

I had done some previous traversing and remonumentation in Section 27. Paul Fairchild tied into my work and then traversed to the N1/4 and NE of Sec.27, to the occupied C1/4 of Sec. 22 and occupied "40" corners between them. He set the N1/4 of Sec.27 based on the field evidence and computations. The final corner also fits the occupation at this corner. Paul and I went over his work and I agree with his conclusions. I removed his iron bar and replaced it with my bar and cap.


Describe or show any material discrepancy between the location of the restored corner and that of the corner previously restored or reestablished.

None known.

RECORD OF DURABLE WITNESS MONUMENTS

MAGNETIC

NO	DESCRIPTION	BEARING	DISTANCE
1	SET A NAIL IN N.E.-SIDE DOUBLE TRUNK OAK	N 05° W	28.05 FT.
2	SET A NAIL IN W.-SIDE 11" OAK	S 01° E	19.64 FT.
3	SET A NAIL IN S.E.-SIDE 17" WHITE OAK	S 19° W	26.55 FT.
4	SET A NAIL IN N.W.-SIDE 18" OAK	S 48° W	25.67 FT.

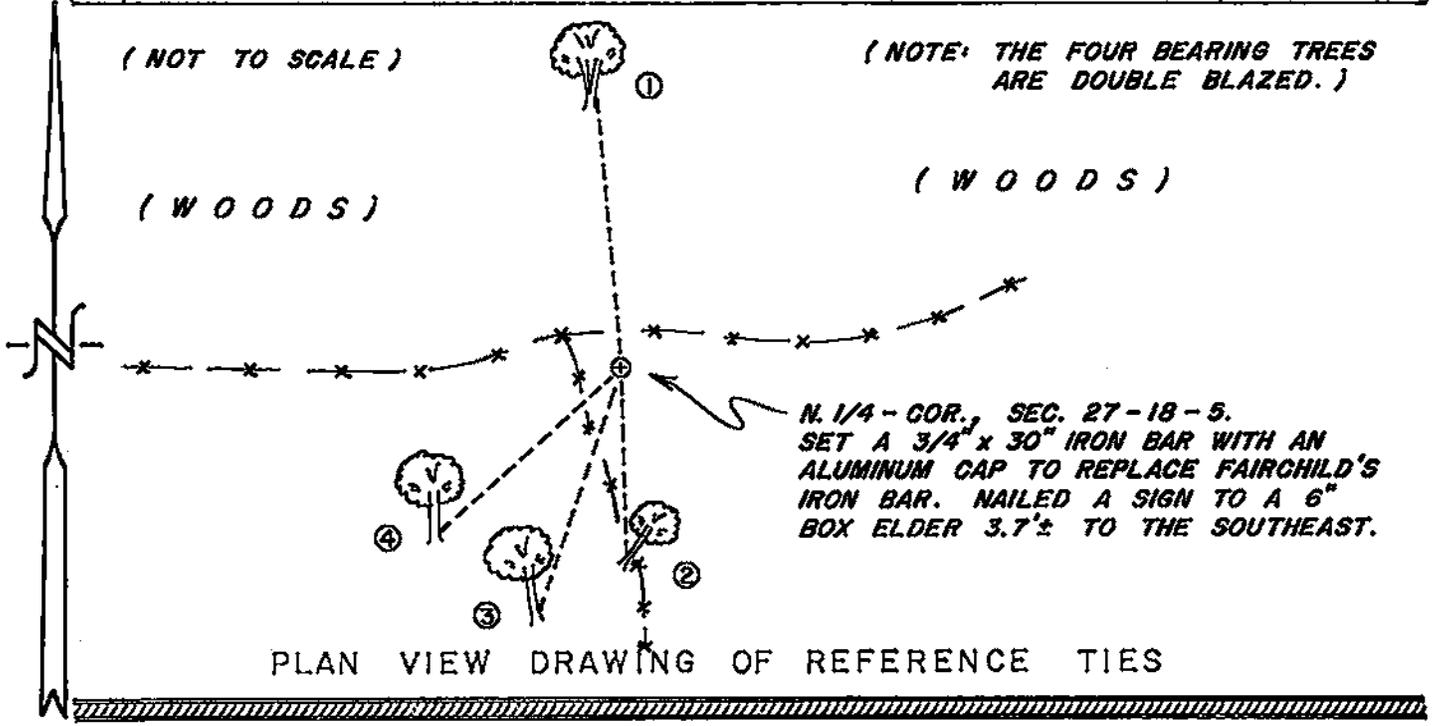


MAP SHOWING DISTANCE AND DIRECTION TO OTHER PUBLIC LAND SURVEY CORNERS USED FOR REESTABLISHING THE CORNER

The location of this corner was determined by Fairchild. No section measurements were made by me at this time.

I, WILLIAM G. JUNG, COUNTY SURVEYOR
 HEREBY CERTIFY THAT THE CORNER LOCATION SHOWN ON THIS RECORD WAS DETERMINED BY ME OR UNDER MY DIRECTION AND CONTROL AND THAT THIS U. S. PUBLIC LAND SURVEY MONUMENT RECORD IS CORRECT AND COMPLETE TO THE BEST OF MY KNOWLEDGE AND BELIEF.

William G. Jung 2/4/99
 Signature Date

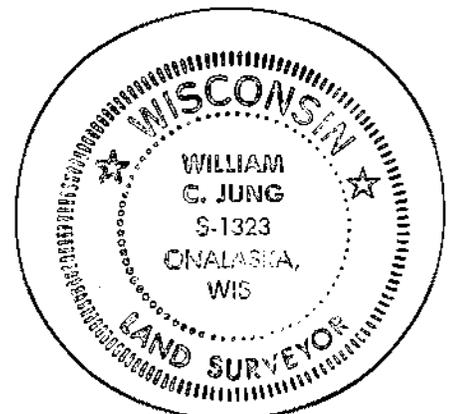

Seal