


21805222000

U. S. PUBLIC LAND SURVEY MONUMENT RECORD

SECTION 23 T 18 N, R 5 W, TOWN OF BURNS

LA CROSSE COUNTY

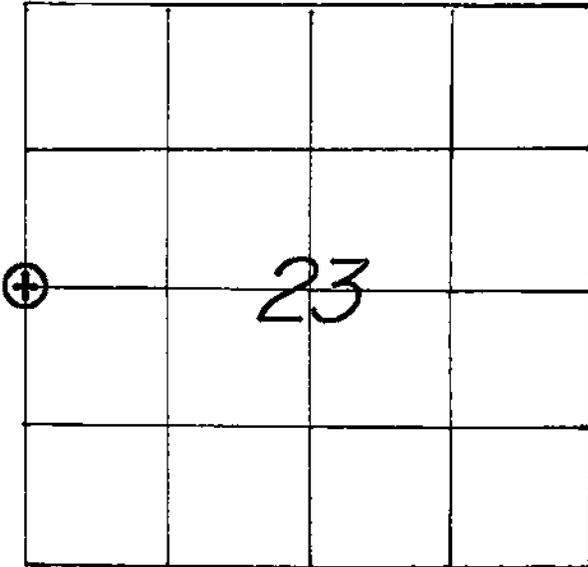

LOCATION OF LANDMARK

CREW: **WILLIAM C. JUNG**
PETER F. FOLLANSBEE
 DATE: **1/08/2002**

WISCONSIN COORDINATE SYSTEM

North **738,142.496**East **1,717,836.583**

Theta Angle

Horiz. Order

Vert. Order

DATUM: **1983 ('91)**

TYPE OF LANDMARK

3/4" x 30" IRON BAR WITH ALUMINUM CAP.

BEARINGS ARE REFERENCED TO

GRID NORTH AS PER SECTION DATA.

Describe any record evidence, monument evidence, testimonial evidence or any other material evidence you considered and whether the monument was found or restored through acceptance of an obliterated evidence location.


After surveying out Section 23, I set this corner on line between the section corners and in the existing East-West fence. The corner was monumented with an iron bar and cap.

Describe or show any material discrepancy between the location of the restored corner and that of the corner previously restored or reestablished.


NONE KNOWN.

RECORD OF DURABLE WITNESS MONUMENTS
MAGNETIC

NO	DESCRIPTION	BEARING	DISTANCE
1	SET A 3/4"x30" IRON BAR WITH AN ALUMINUM CAP	WEST ±	51.48 FT.
2	SET A NAIL IN S.E.-SIDE OF A 15" OAK	N 45° E	SLOPE=18.40'
3	SET A NAIL IN N.-SIDE OF A 12" WHITE OAK	N 87° E	19.13 FT.
4	SET A NAIL IN E.-SIDE OF A 15-1/2" OAK	S 05° W	8.04 FT.

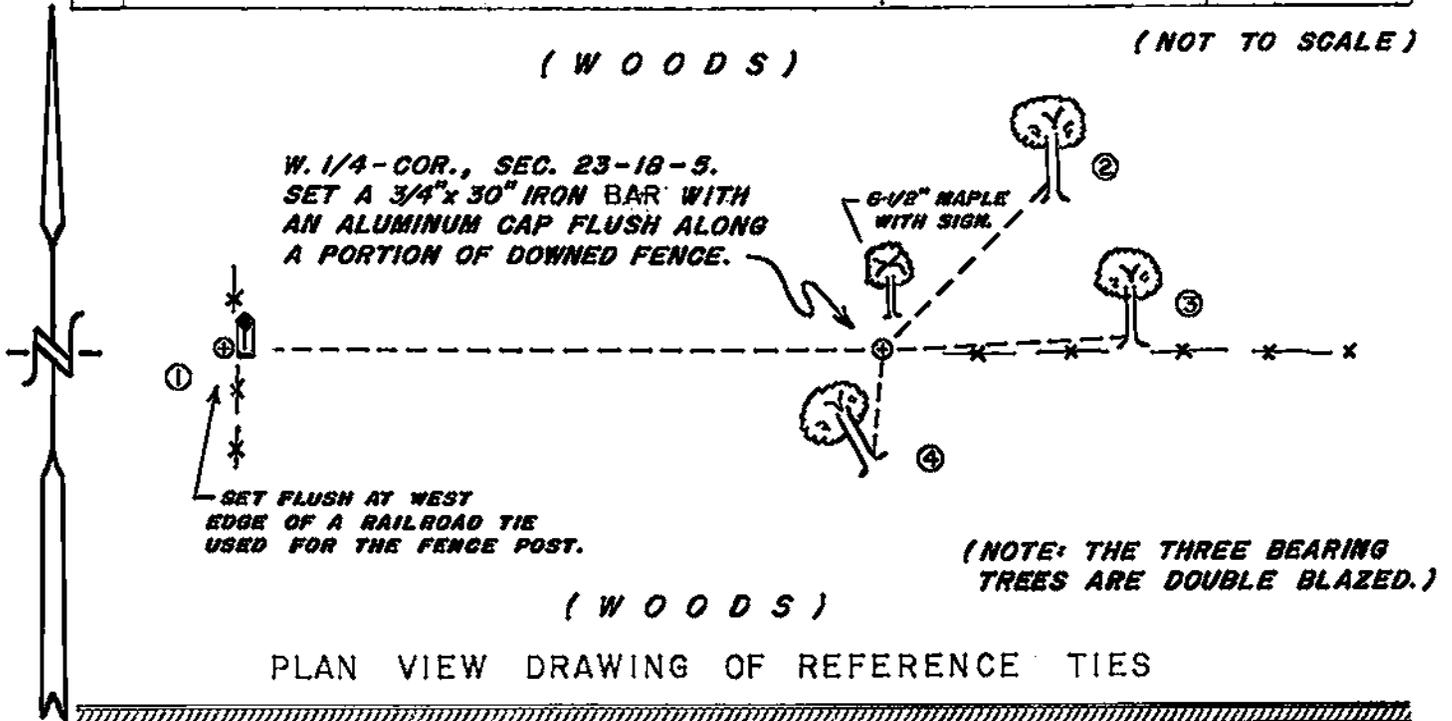

MAP SHOWING DISTANCE AND DIRECTION TO OTHER PUBLIC LAND SURVEY CORNERS USED FOR REESTABLISHING THE CORNER

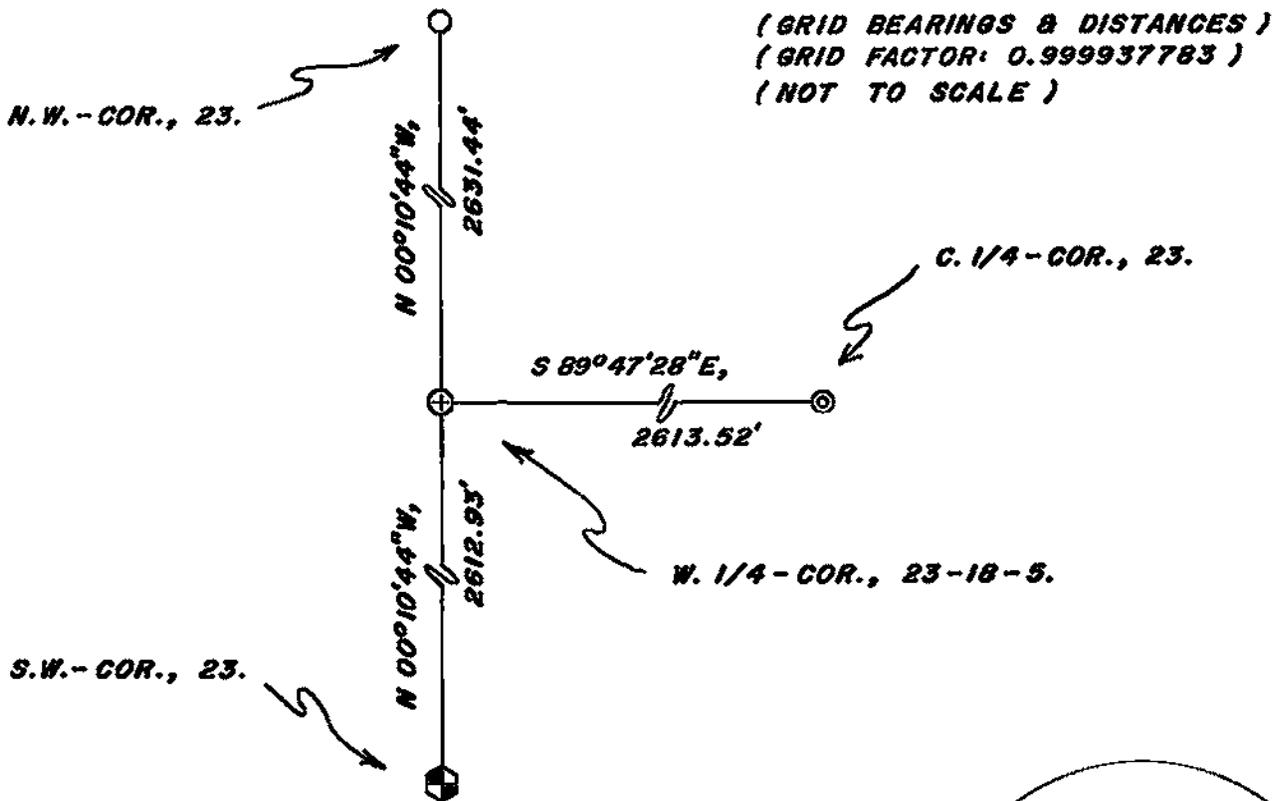

I, WILLIAM C. JUNG, COUNTY SURVEYOR
HEREBY CERTIFY THAT THE CORNER LOCATION SHOWN ON THIS RECORD WAS DETERMINED BY ME OR UNDER MY DIRECTION AND CONTROL AND THAT THIS U. S. PUBLIC LAND SURVEY MONUMENT RECORD IS CORRECT AND COMPLETE TO THE BEST OF MY KNOWLEDGE AND BELIEF.

William C. Jung 4/18/02
Signature Date



Seal