

COUNTY SURVEYOR FORM NO. 1

I, Gary L. Dechant, do hereby certify that on the 6th day of March, 1984, I found (evidence) ~~(see evidence)~~ of the NW corner of Section 30, T 18 N, R 4 W Fourth Principal Meridian, and I re-established said corner according to the Wisconsin Statutes as shown and described hereon.

Dated this 8th day of March, 1984.

Harley A. Sime
 Registered Land Surveyor, S-1724

CERTIFIED LAND CORNER

History of corner establishment since Original Government Survey
 Fred Holden, in April of 1899, was here at this corner and lists two bearing trees in his notes.

Description of corner evidence found:
 Accepted fence corner as best evidence as it fits the original government notes distance to the NW corner within 1'± and fits conditions to the south very well also.




Approved: HARLEY A. SIME
 MONROE CO. SURVEYOR

Description of corner and witness monuments, references and accessories used to perpetuate the original or re-established location of this corner:

Witnesses to corner location:

Lawrence A. Feddersen S-12226

Gary L. Dechant

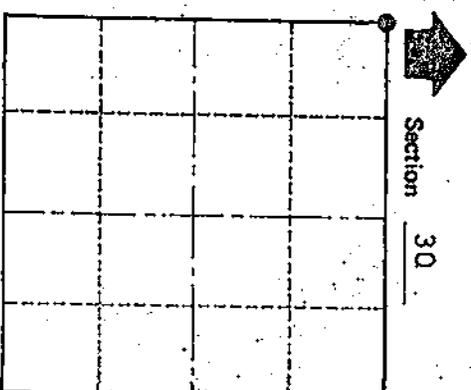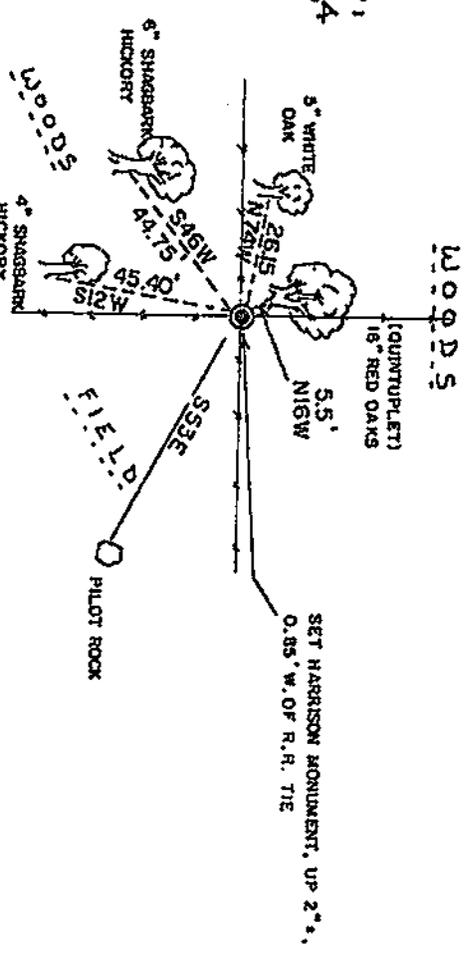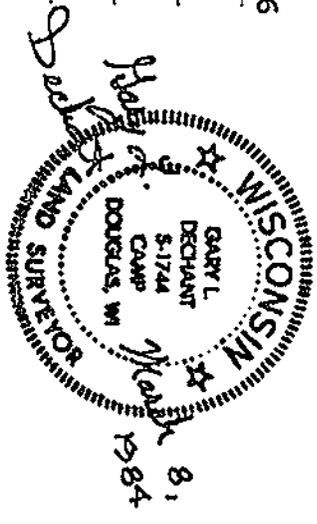

SURVEY CONTROL ORDER

Horizontal	
Vertical	

WISCONSIN COORDINATE SYSTEM

East (X)	North (Y)	Elevation (Z)	Zone
Corner			
Control Sta. Name			

(Trees double blazed, scribed, and with N&C's set)

Town Sparta
 County of Monroe