


U. S. PUBLIC LAND SURVEY MONUMENT RECORD

SECTION 25 T 18 N, R 5 W, TOWN OF BURNS

LA CROSSE COUNTY

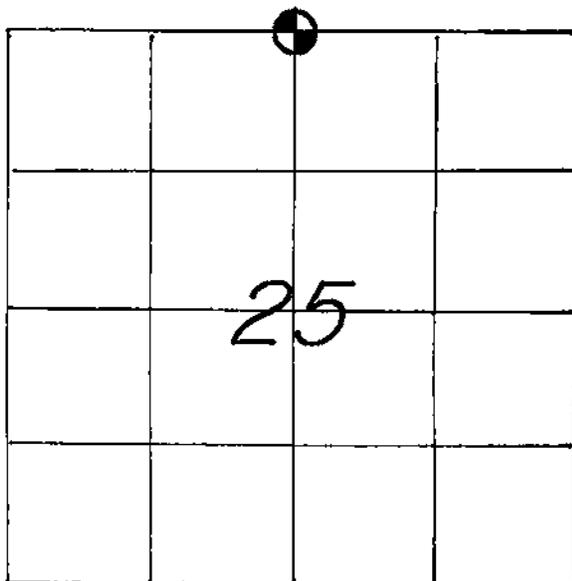

LOCATION OF LANDMARK

CREW: WILLIAM C. JUNG

PETER F. FOLLANSBEE

DATE: 8/10/1998

WISCONSIN COORDINATE SYSTEM

North

East

Theta Angle

Horiz. Order

Vert. Order

TYPE OF LANDMARK

BRASS CAP LUNDE MARKER.

BEARINGS ARE REFERENCED TO

Assumed

Describe any record evidence, monument evidence, testimonial evidence or any other material evidence you considered and whether the monument was found or restored through acceptance of an obliterated evidence location.


Tim Jeatran traversed to this point and set a railroad spike at the old occupied corner. The old records indicate that this 1/4 corner has been a property corner for some time. The line fence on the South line of the cow lane only recently shows up as a property line. The older fence corner is obviously much better evidence. I therefore accepted it as the best available evidence of the original government corner position, removed the railroad spike, and replaced it with a brass capped Lunde marker. Describe or show any material discrepancy between the location of the restored corner and that of the corner previously restored or reestablished.

NONE KNOWN.

RECORD OF DURABLE WITNESS MONUMENTS


MAGNETIC

NO	DESCRIPTION	BEARING	DISTANCE
1	SET A NAIL IN THE S.-SIDE OF AN 8" ELM	S 75° W	13.70 FT.
2	SET A R.K. NAIL IN THE E.-SIDE OF A 10" HICKORY	N 07° E	15.50 FT.
3	SET A R.K. NAIL IN THE S.E.-SIDE OF AN 8" HICKORY	N 35° E	11.66 FT.
4	SET A NAIL IN THE N.E.-SIDE OF A 5" ELM	S 70° E	34.63 FT.

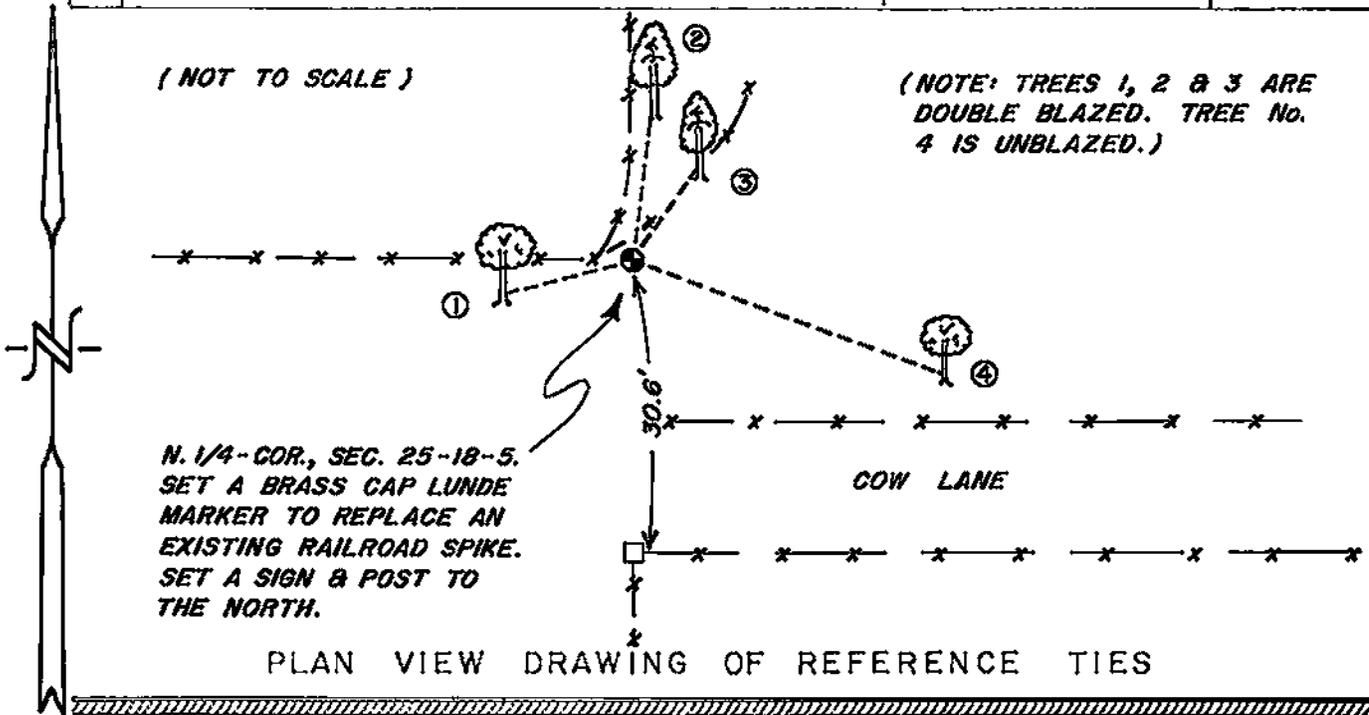

MAP SHOWING DISTANCE AND DIRECTION TO OTHER PUBLIC LAND SURVEY CORNERS USED FOR REESTABLISHING THE CORNER (not to scale)

(T. JEATRAN MEASUREMENTS)

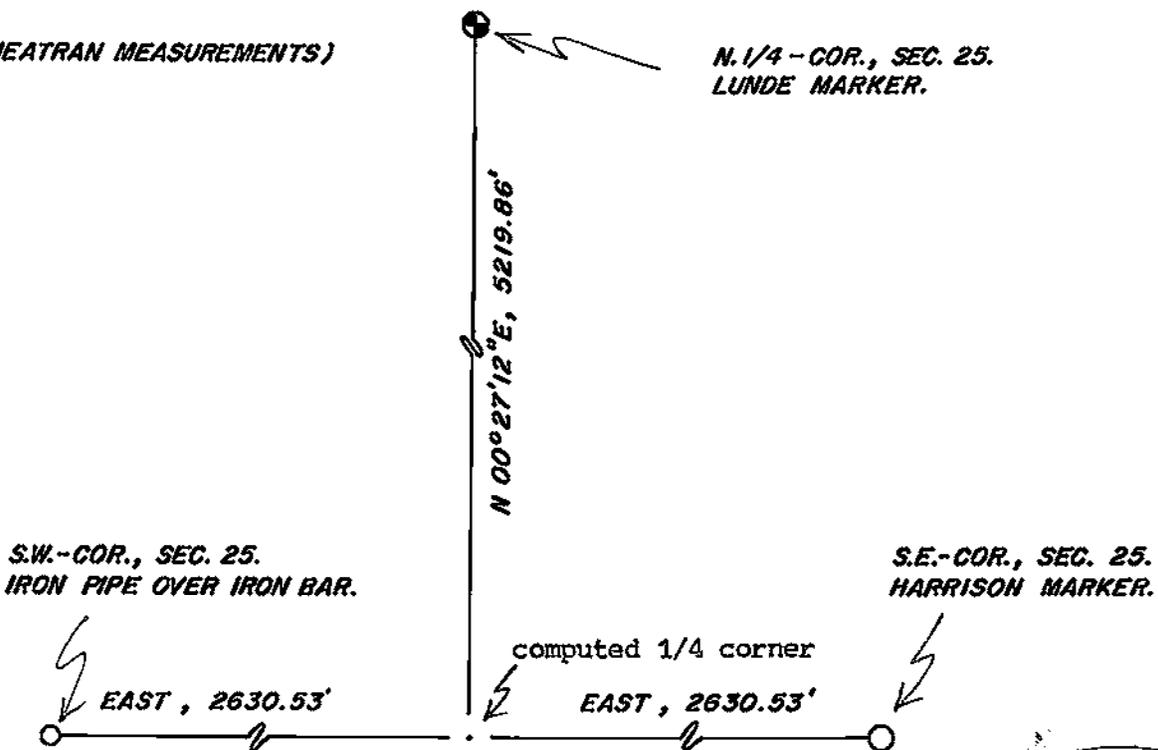

I, WILLIAM C. JUNG, COUNTY SURVEYOR
HEREBY CERTIFY THAT THE CORNER LOCATION SHOWN ON THIS RECORD WAS DETERMINED BY ME OR UNDER MY DIRECTION AND CONTROL AND THAT THIS U. S. PUBLIC LAND SURVEY MONUMENT RECORD IS CORRECT AND COMPLETE TO THE BEST OF MY KNOWLEDGE AND BELIEF.

William C. Jung
Signature

8/24/98
Date



Seal