

# MONROE COUNTY - U.S. PUBLIC LAND SURVEY MONUMENT RECORD

TYPE OF MOMUMENT Cast Iron Harrison Monument  
 REFERENCED FOR SURVEY RECORDED IN CSM# Vol. 12, Pg. 117 OR CSR#  
Lax County  
 SURVEYORS FILE # OR PROJECT# C:/pcs/proj/laxland  
 DRAWN BY Dallas E. Wilhite

CORNER VOL \_\_\_\_\_ PAGE \_\_\_\_\_  
 CORNER # \_\_\_\_\_  
 SECTION 19 T 18 N R 4W

### GEOGRAPHIC LOCATION:


LATT: \_\_\_\_\_ ° \_\_\_\_\_ ' \_\_\_\_\_ "  
 LONG: \_\_\_\_\_ ° \_\_\_\_\_ ' \_\_\_\_\_ "

COORDINATE SYSTEM  
(TO BE ASSIGNED BY COUNTY)

ELLIPSOID HEIGHT \_\_\_\_\_ m \_\_\_\_\_ ft  
 ORTHO HEIGHT \_\_\_\_\_ m \_\_\_\_\_ ft

N= \_\_\_\_\_  
 E= \_\_\_\_\_

Estimated height accuracy + \_\_\_\_\_

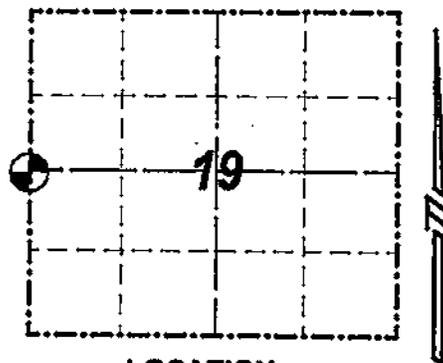

LOCATION  
(INDICATE W/ MONUMENT SYMBOL)

### BASIS FOR MONUMENT LOCATION

Please describe if this is a found, obliterated or lost corner. Give a complete history of the corner listing the vol. & page, dates, surveyor and description of found monument. Please list all parole testimony and who provided it as well as other witness' of recovery. Please describe the best way to reach this corner. Indicate how obstructed this monument might be for GPS observations. Continue on backside if necessary.

Could not find any original evidence. I believe I found Holdens 5" White Oak Tree. This tree fits the North-South fence really good and also fits the half way split between the Northeast corner and the Southeast corner really good. I re-established this corner by using Holdens tree, the North-South fence and the half way split of the East line of Section 24.

The best way to get to this corner is to come in from the North, across fields to within 650 feet of corner. This corner could be observed at low leaf cover and good satellite configuration.

This corner was set for a CSM that was completed in Section 24, T18N, R5W, La Crosse County, Wisconsin. Vol. 12, page 117.

SEAL:



CERTIFIED CORRECT AND COMPLETE  
 TO THE BEST OF MY KNOWLEDGE  
 AND BELIEF:  
Dallas E. Wilhite  
 REGISTERED LAND SURVEYOR  
 DATE: 10/31/05

**TIE SKETCH** Show at least four ties. Show fence lines-roads-topo features- size and type of witness trees-trails if available.

