

I, GARY, L. Dechant, do hereby certify that on the 6th day of March 19 84, I found (evidence) ~~(evidence)~~ of the SW corner of Section 30, T. 18 N., R. 4 W. Fourth Principal Meridian, and I re-established said corner according to the Wisconsin Statutes as shown and described hereon.

Dated this 8th day of March 19 84.

Gary L. Dechant

Registered Land Surveyor, S-1744

History of corner establishment since Original Government Survey

Fred Holden in April of 1899, at that time Deputy County Surveyor, under Hamilton Larue, shows two bearing trees in his notes for this corner.

Description of corner evidence found:


Accepted the fence corner as best available evidence as it fits other field evidence very well.

Description of corner and witness monuments, references and accessories used to perpetuate the original or re-established location of this corner:



Witnesses to corner location:

Lawrence A. Feddersen S-1226

Gary L. Dechant

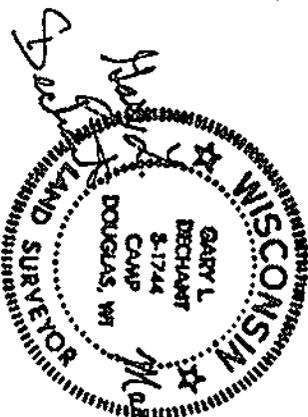

Approved: **HARLEY A. SIMP**
MONROE CO. SURVEYOR

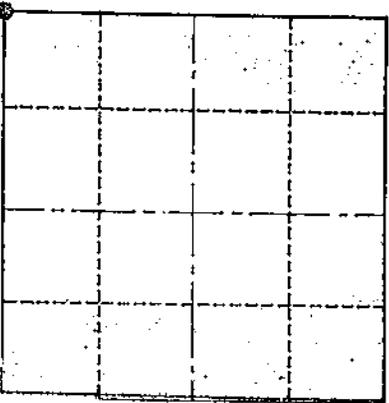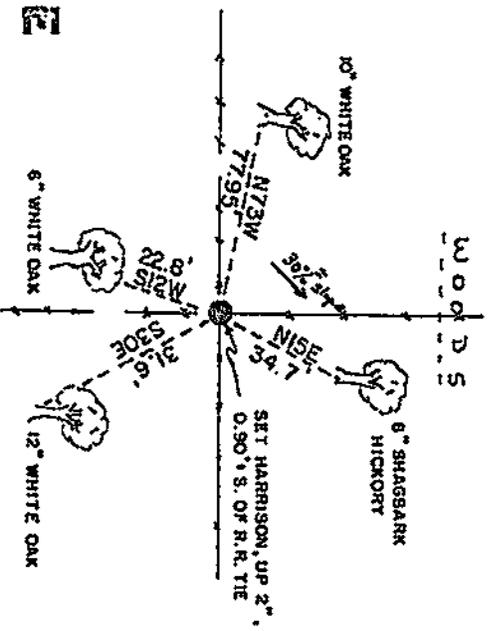

(Trees double blazed, scribed and with N&C's set)

WISCONSIN COORDINATE SYSTEM

SURVEY CONTROL ORDER		East (X)		North (Y)		Elevation (Z)		Zone	
Horizontal									
Vertical									
Corner									
Control Sta. Name									

Town Sparta
County of Montroe