


U. S. PUBLIC LAND SURVEY MONUMENT RECORD

SECTION 25 T 18 N, R 5 W, TOWN OF BURNS  
LA CROSSE COUNTY

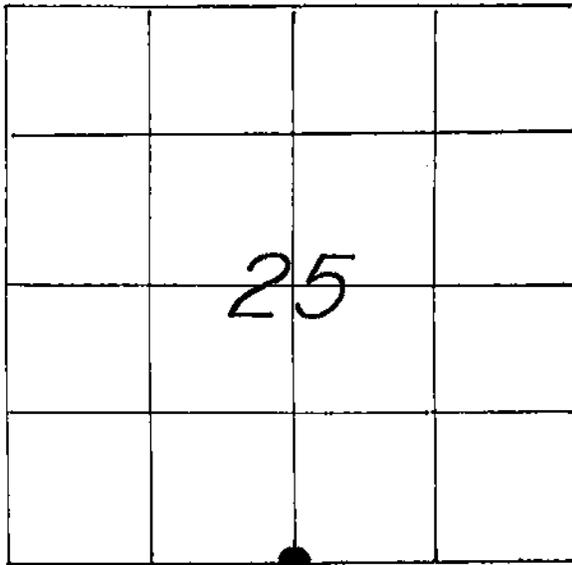

WISCONSIN COORDINATE SYSTEM
North
East
Theta Angle
Horiz. Order
Vert. Order
TYPE OF LANDMARK
<i>3/4" x 24" ROUND IRON BAR.</i>
BEARINGS ARE REFERENCED TO

LOCATION OF LANDMARK

CREW: WILLIAM C. JUNG  
PETER F. FOLLANSBEE  
DATE: 9/01/1998

Describe any record evidence, monument evidence, testimonial evidence or any other material evidence you considered and whether the monument was found or restored through acceptance of an obliterated evidence location.


Tim Jeatran set an iron bar at this corner using single proportionate measurement. I agree with this method and tied off the corner. This also agrees with the new "bridge" plan done recently by a consultant.

Describe or show any material discrepancy between the location of the restored corner and that of the corner previously restored or reestablished.

*NONE KNOWN.*

RECORD OF DURABLE WITNESS MONUMENTS

NO	DESCRIPTION	MAGNETIC	
		BEARING	DISTANCE
1	THE CENTER OF THE STOP SIGN POST (AT THE BASE)	N 81° W	46.22 FT.
2	THE CENTER OF THE "DEAD END" SIGN POST (AT THE BASE)	N 63° E	14.97 FT.
3	SET A NAIL IN THE N-SIDE OF A LARGE UNBLAZED WILLOW	N 83° E	39.44 FT.
4	THE CENTER OF THE "LAYTON ROAD" STREET SIGN POST	S 22° W	14.79 FT.

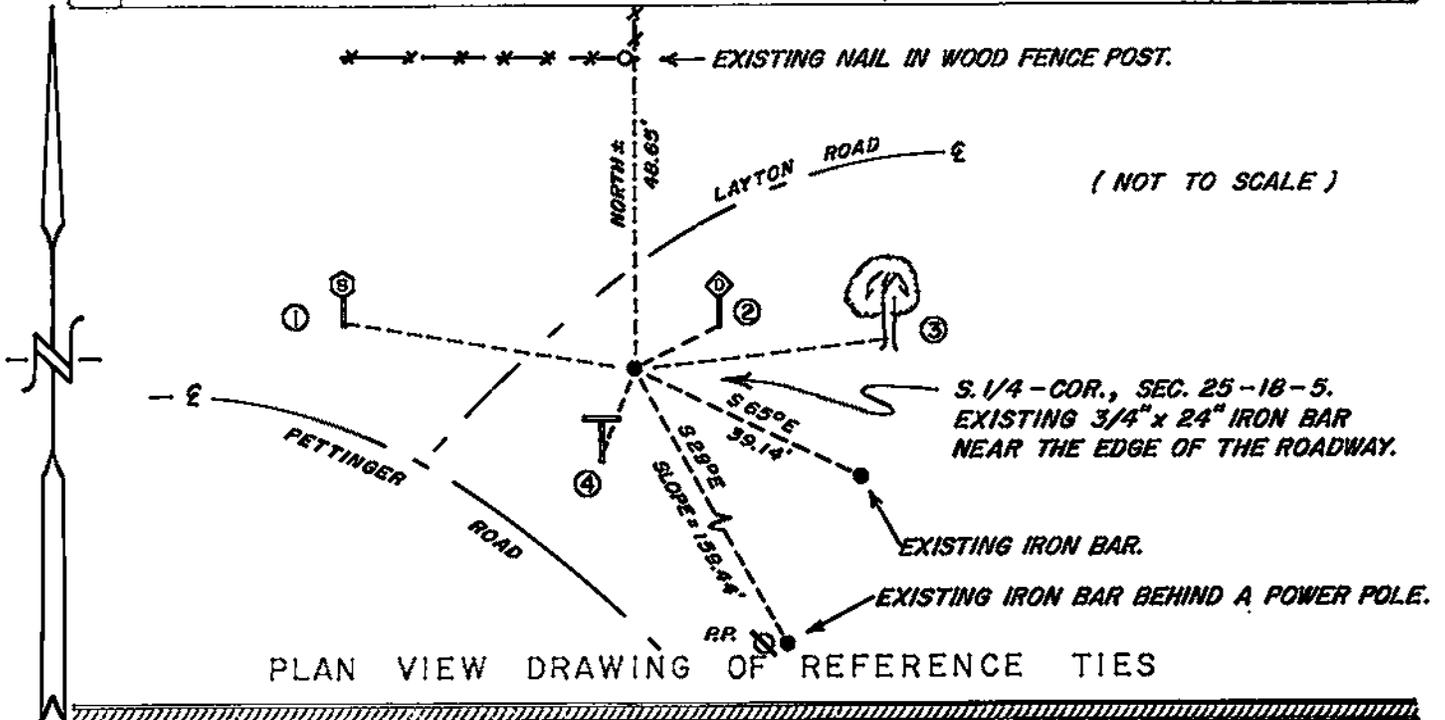

MAP SHOWING DISTANCE AND DIRECTION TO OTHER PUBLIC LAND SURVEY CORNERS USED FOR REESTABLISHING THE CORNER

No section measurements were made by me at this time. The position of this corner was confirmed through Jeatran's section work.

I, WILLIAM C. JUNG, COUNTY SURVEYOR  
 HEREBY CERTIFY THAT THE CORNER LOCATION SHOWN ON THIS RECORD WAS DETERMINED BY ME OR UNDER MY DIRECTION AND CONTROL AND THAT THIS U. S. PUBLIC LAND SURVEY MONUMENT RECORD IS CORRECT AND COMPLETE TO THE BEST OF MY KNOWLEDGE AND BELIEF.

William C. Jung  
 Signature

October 27, 1998  
 Date



Seal