

History of corner establishment since Original Government Survey

Fred Hoiden in April of 1899, at that time Deputy County Surveyor under Hamilton LaRue, was at this corner and shows two bearing trees in his notes for this corner.

Description of corner evidence found:

Found a stone monument with half a cross at a four way fence corner. Used the stone as the corner as it fits line between the section corners extremely well and is half way between the section corners within 1". We do not know who set the stone as it is not on record in the Monroe County Courthouse.



I, Gary L. Dechant, do hereby certify that on the 6th day of March 1984, I found (evidence) of the W 1/4 Section 30, T 18 N, R 4 W Fourth Principal Meridian, and I re-established said corner according to the Wisconsin Statutes as shown and described hereon.
Dated this 8th day of March 1984.
Gary L. Dechant
Registered Land Surveyor, S-1744

Description of corner and witness monuments, references and accessories used to perpetuate the original or re-established location of this corner:

Witnesses to corner location:

Lawrence A. Feddersen S-12226

Gary L. Dechant

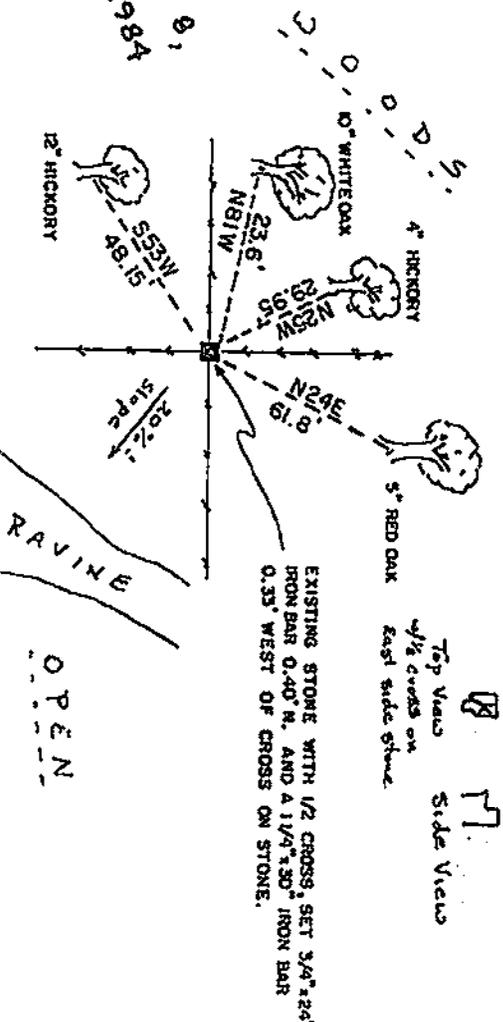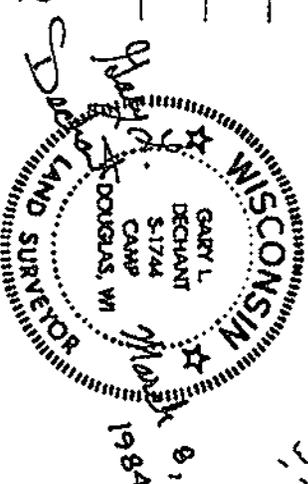


STONE

Top View Side View

EXISTING STONE WITH 1/2 CROSS, SET 3/4" x 2 1/2" IRON BAR 0.40" N. AND A 1/4" x 3/8" IRON BAR 0.33" WEST OF CROSS ON STONE.

Section 30

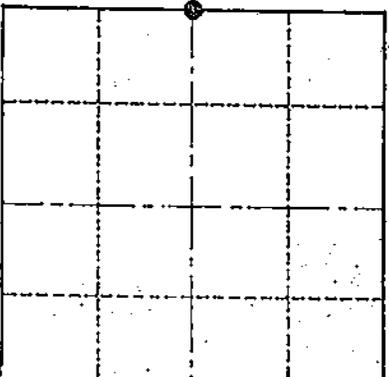

LOCATION CORNER
T 18 N R 4 W
WISCONSIN

Approved: HARLEY A. SIMME
MONROE CO. SURVEYOR

SURVEY CONTROL ORDER

Horizontal	East (X)	North (Y)	Elevation (Z)	Zone
Vertical	Corner			
	Control Sta. Name			

WISCONSIN COORDINATE SYSTEM

(Trees double blazed, scribed, and with N&C's set)

County of Monroe
Town Sparta