


## U. S. PUBLIC LAND SURVEY MONUMENT RECORD

SECTION 36 T 18 N, R 5 W, TOWN OF BURNS

LA CROSSE COUNTY

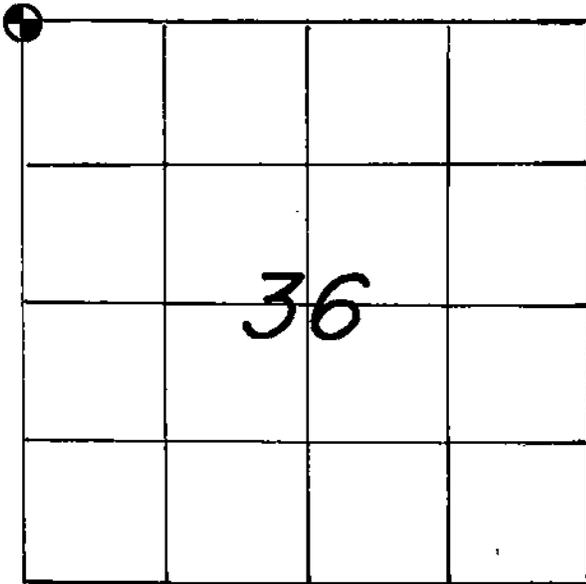

LOCATION OF LANDMARK

Crew: WILLIAM C. JUNG  
 PETER F. FOLLANSBEE  
 Date: 4/01/1996

Describe any record evidence, monument evidence, testimonial evidence or any other material evidence you considered and whether the monument was found or restored through acceptance of an obliterated evidence location.

We found an iron bar at the old occupied corner. This bar had been used as the corner in previous survey work. I accepted the occupied corner as the best available evidence of the original government corner position. We set a pipe over the bar.

Describe or show any material discrepancy between the location of the restored corner and that of the corner previously restored or reestablished.

None Known.

WISCONSIN COORDINATE SYSTEM

North

East

Theta Angle

Horiz. Order

Vert. Order

TYPE OF LANDMARK

1½" x 28" I.P. over Ex. ½" I.B.

BEARINGS ARE REFERENCED TO

