


21805272000

U. S. PUBLIC LAND SURVEY MONUMENT RECORD

SECTION 26 T 18 N, R 5 W, TOWN OF BURNS

LA CROSSE COUNTY

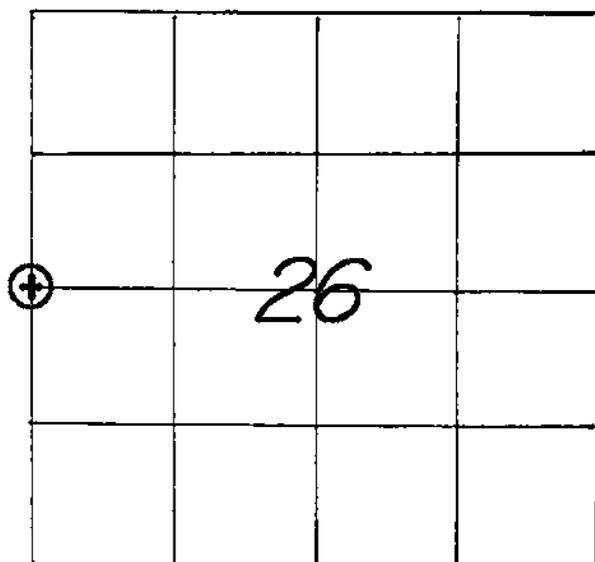

LOCATION OF LANDMARK

CREW: **WILLIAM G. JUNG**
PETER F. FOLLANSBEE
 DATE: **1/04/2002**

WISCONSIN COORDINATE SYSTEM	
North	732,928.300
East	1,717,825.949
Theta Angle	
Horiz. Order	
Vert. Order	
TYPE OF LANDMARK	
3/4" x 30" IRON BAR WITH ALUMINUM CAP.	
BEARINGS ARE REFERENCED TO	
GRID NORTH AS PER SECTION DATA.	

Describe any record evidence, monument evidence, testimonial evidence or any other material evidence you considered and whether the monument was found or restored through acceptance of an obliterated evidence location.

After completing our section measurements, I accepted the old occupied corner as the best available evidence of the original government corner position and monumented the corner with an iron bar and cap.

Describe or show any material discrepancy between the location of the restored corner and that of the corner previously restored or reestablished.

NONE KNOWN.

