


## U. S. PUBLIC LAND SURVEY MONUMENT RECORD

SECTION 28 T 18 N, R 5 W, TOWN OF FARMINGTON

LA CROSSE COUNTY

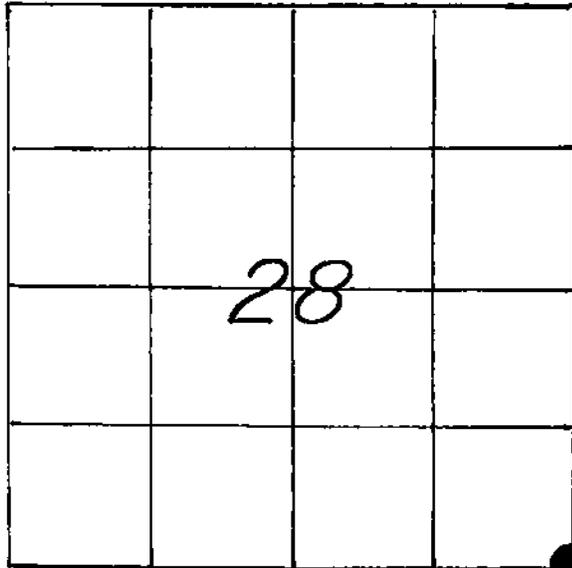

LOCATION OF LANDMARK

Crew: WILLIAM C. JUNG

PETER F. FOLLANSBEE

Date: 3/10/1997

Describe any record evidence, monument evidence, testimonial evidence or any other material evidence you considered and whether the monument was found or restored through acceptance of an obliterated evidence location.

This corner was set by double proportionate measurement as "per law". An iron bar was set at the corner.

Describe or show any material discrepancy between the location of the restored corner and that of the corner previously restored or reestablished.

None Known.

## WISCONSIN COORDINATE SYSTEM

North

East

Theta Angle

Horiz. Order

Vert. Order

## TYPE OF LANDMARK


3/4" x 30" Iron Bar(no cap)

BEARINGS ARE REFERENCED TO

ASSUMED NORTH.


RECORD OF DURABLE WITNESS MONUMENTS  
MAGNETIC

NO	DESCRIPTION	BEARING	DISTANCE
1	Set P.K. Nail in NW-side 6½" Burr Oak	S 60°W	11.40 Ft.
2	Set P.K. Nail in W.-side 8½" Burr Oak	North	30.60 Ft.
3	Set P.K. Nail in SW-side 7" Burr Oak	S 69°E	27.27 Ft.
4	Set P.K. Nail in SW-side 6" Cedar	S 61°E	51.60 Ft.

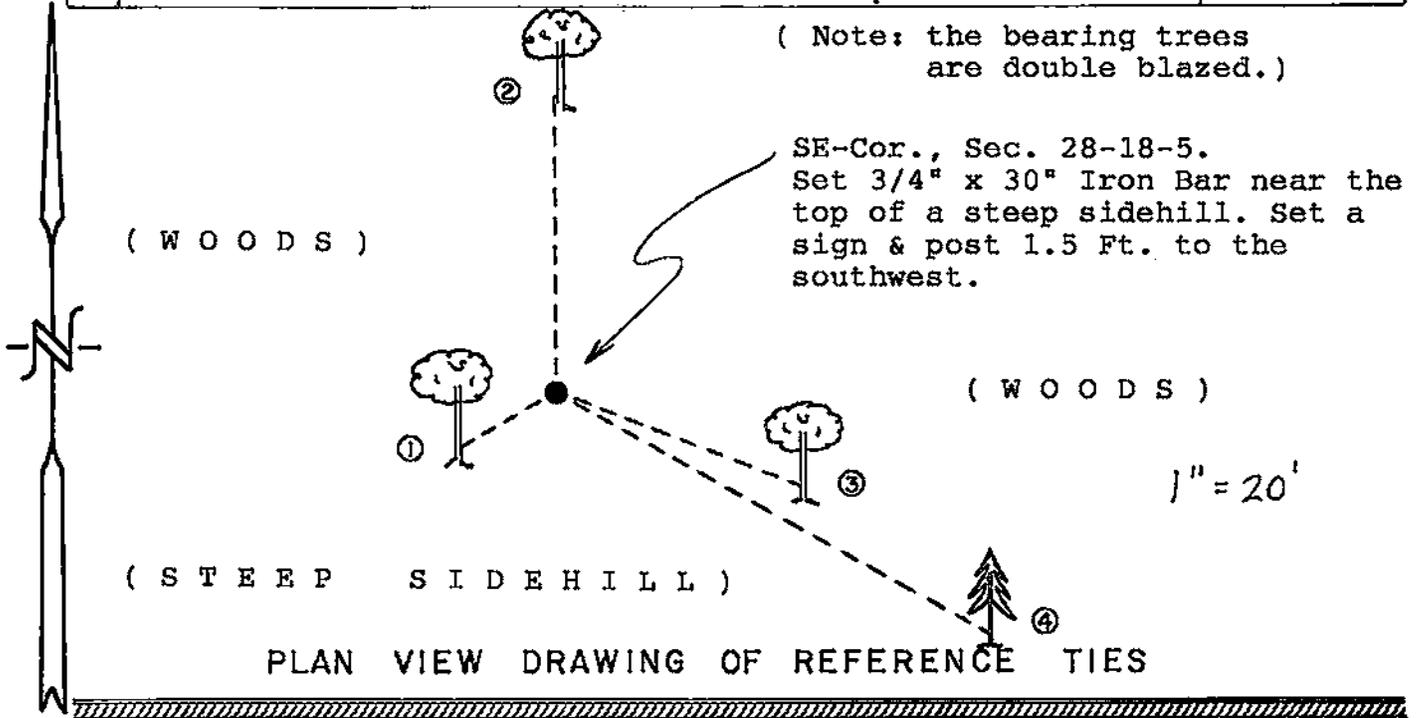


MAP SHOWING DISTANCE AND DIRECTION TO OTHER PUBLIC LAND SURVEY CORNERS USED FOR REESTABLISHING THE CORNER

(Not to scale!)

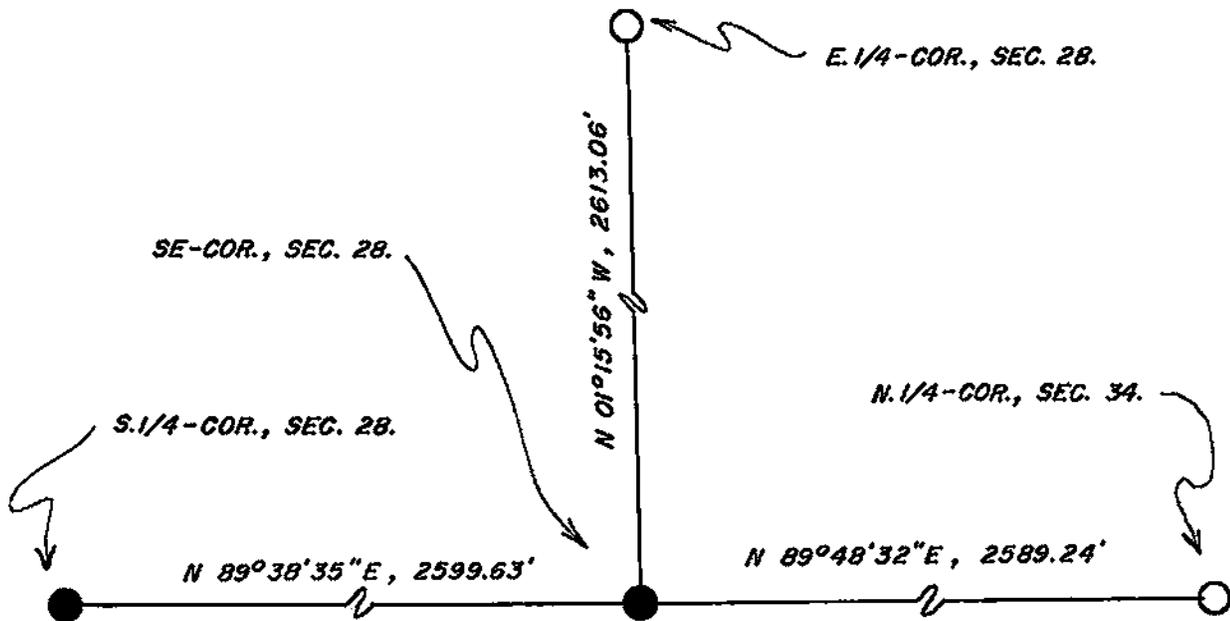

I, William C. Jung, County Surveyor  
HEREBY CERTIFY THAT THE CORNER LOCATION SHOWN ON THIS RECORD WAS DETERMINED BY ME OR UNDER MY DIRECTION AND CONTROL AND THAT THIS U. S. PUBLIC LAND SURVEY MONUMENT RECORD IS CORRECT AND COMPLETE TO THE BEST OF MY KNOWLEDGE AND BELIEF.

William C. Jung      6/12/97  
Signature      Date

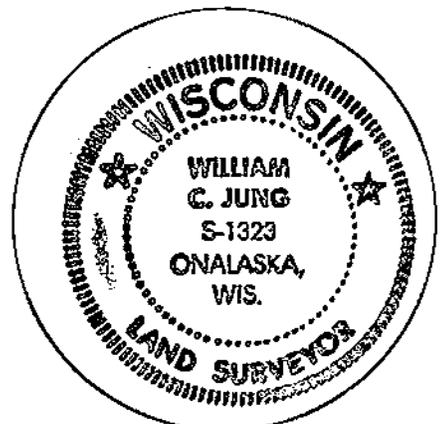

Seal