


U. S. PUBLIC LAND SURVEY MONUMENT RECORD

SECTION 28 T 18 N, R 5 W, TOWN OF FARMINGTON  
 LA CROSSE COUNTY

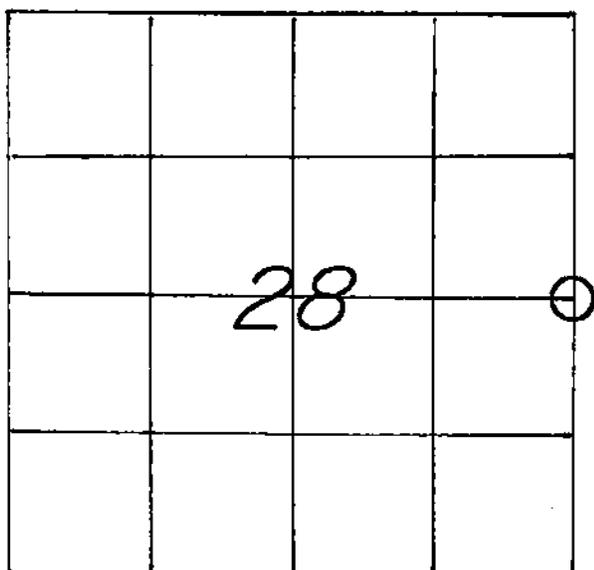

LOCATION OF LANDMARK

Crew: WILLIAM C. JUNG  
 PETER F. FOLLANSBEE  
 Date: 2/03/1997

WISCONSIN COORDINATE SYSTEM
North
East
Theta Angle
Horiz. Order
Vert. Order
TYPE OF LANDMARK
1" Iron Pipe.
BEARINGS ARE REFERENCED TO
Assumed North.

Describe any record evidence, monument evidence, testimonial evidence or any other material evidence you considered and whether the monument was found or restored through acceptance of an obliterated evidence location.

I've accepted the old occupied corner as the best available evidence of the original government corner position and monumented it with an Iron Pipe.

Describe or show any material discrepancy between the location of the restored corner and that of the corner previously restored or reestablished.


None Known.

RECORD OF DURABLE WITNESS MONUMENTS  
MAGNETIC

NO	DESCRIPTION	BEARING	DISTANCE
1	Set P.K. Nail in NW-side 17½" Oak	S 15° W	Sl.=23.26'
2	Set P.K. Nail in SE-side 12½" Oak	S 59° W	9.17 Ft.
3	Set P.K. Nail in SW-side 15½" Oak	N 27° W	22.85 Ft.
4	Set P.K. Nail in NW-side 9½" Hickory	N 40° E	Sl.=65.77'


( Not to scale )  
( Note: all Bearing Trees are unblazed. )

E.¼-Cor., Sec. 28-18-5.  
Set 1" Iron Pipe at fence intersection. Nailed a sign to B.T. #2.

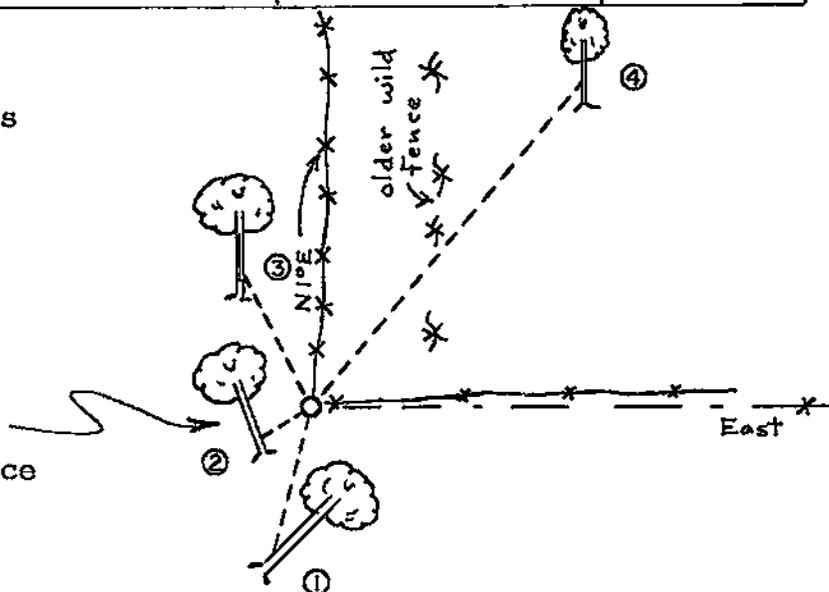


PLAN VIEW DRAWING OF REFERENCE TIES

MAP SHOWING DISTANCE AND DIRECTION TO OTHER PUBLIC LAND SURVEY CORNERS USED FOR REESTABLISHING THE CORNER

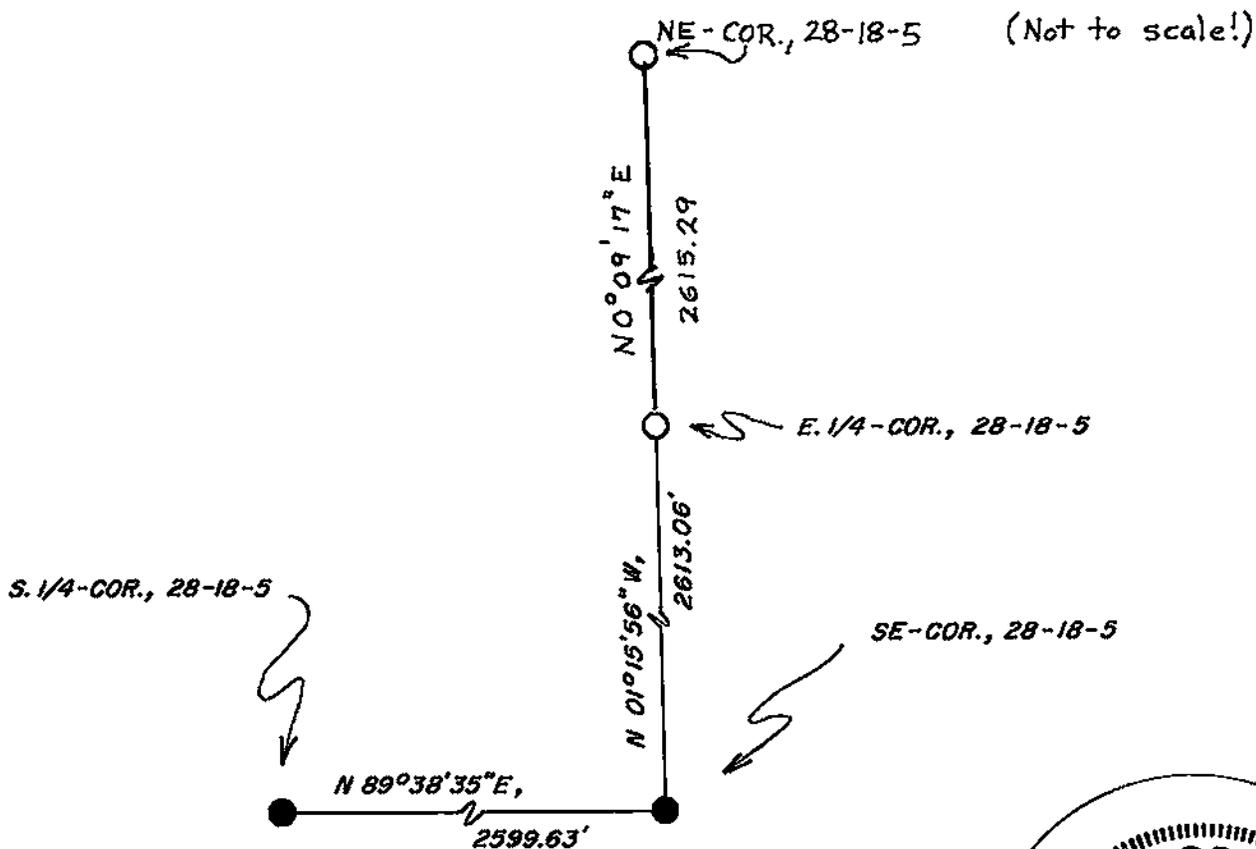

I, William C. Jung, County Surveyor  
HEREBY CERTIFY THAT THE CORNER LOCATION SHOWN ON THIS RECORD  
WAS DETERMINED BY ME OR UNDER MY DIRECTION AND CONTROL AND  
THAT THIS U. S. PUBLIC LAND SURVEY MONUMENT RECORD IS CORRECT  
AND COMPLETE TO THE BEST OF MY KNOWLEDGE AND BELIEF.

William C. Jung 6/12/97  
Signature Date

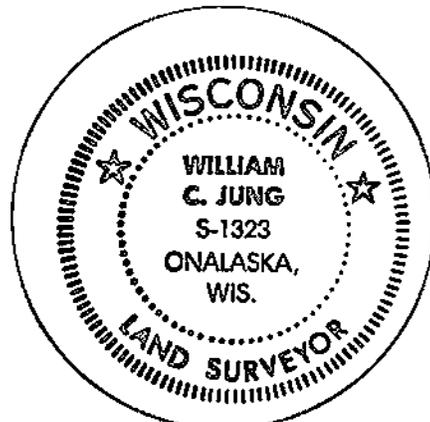

Seal